

SECTION

33


SE NE

11-1340

lower Dry Cr. Check

TOWNSHIP 40 S., RANGE 32 E., W. M.

North

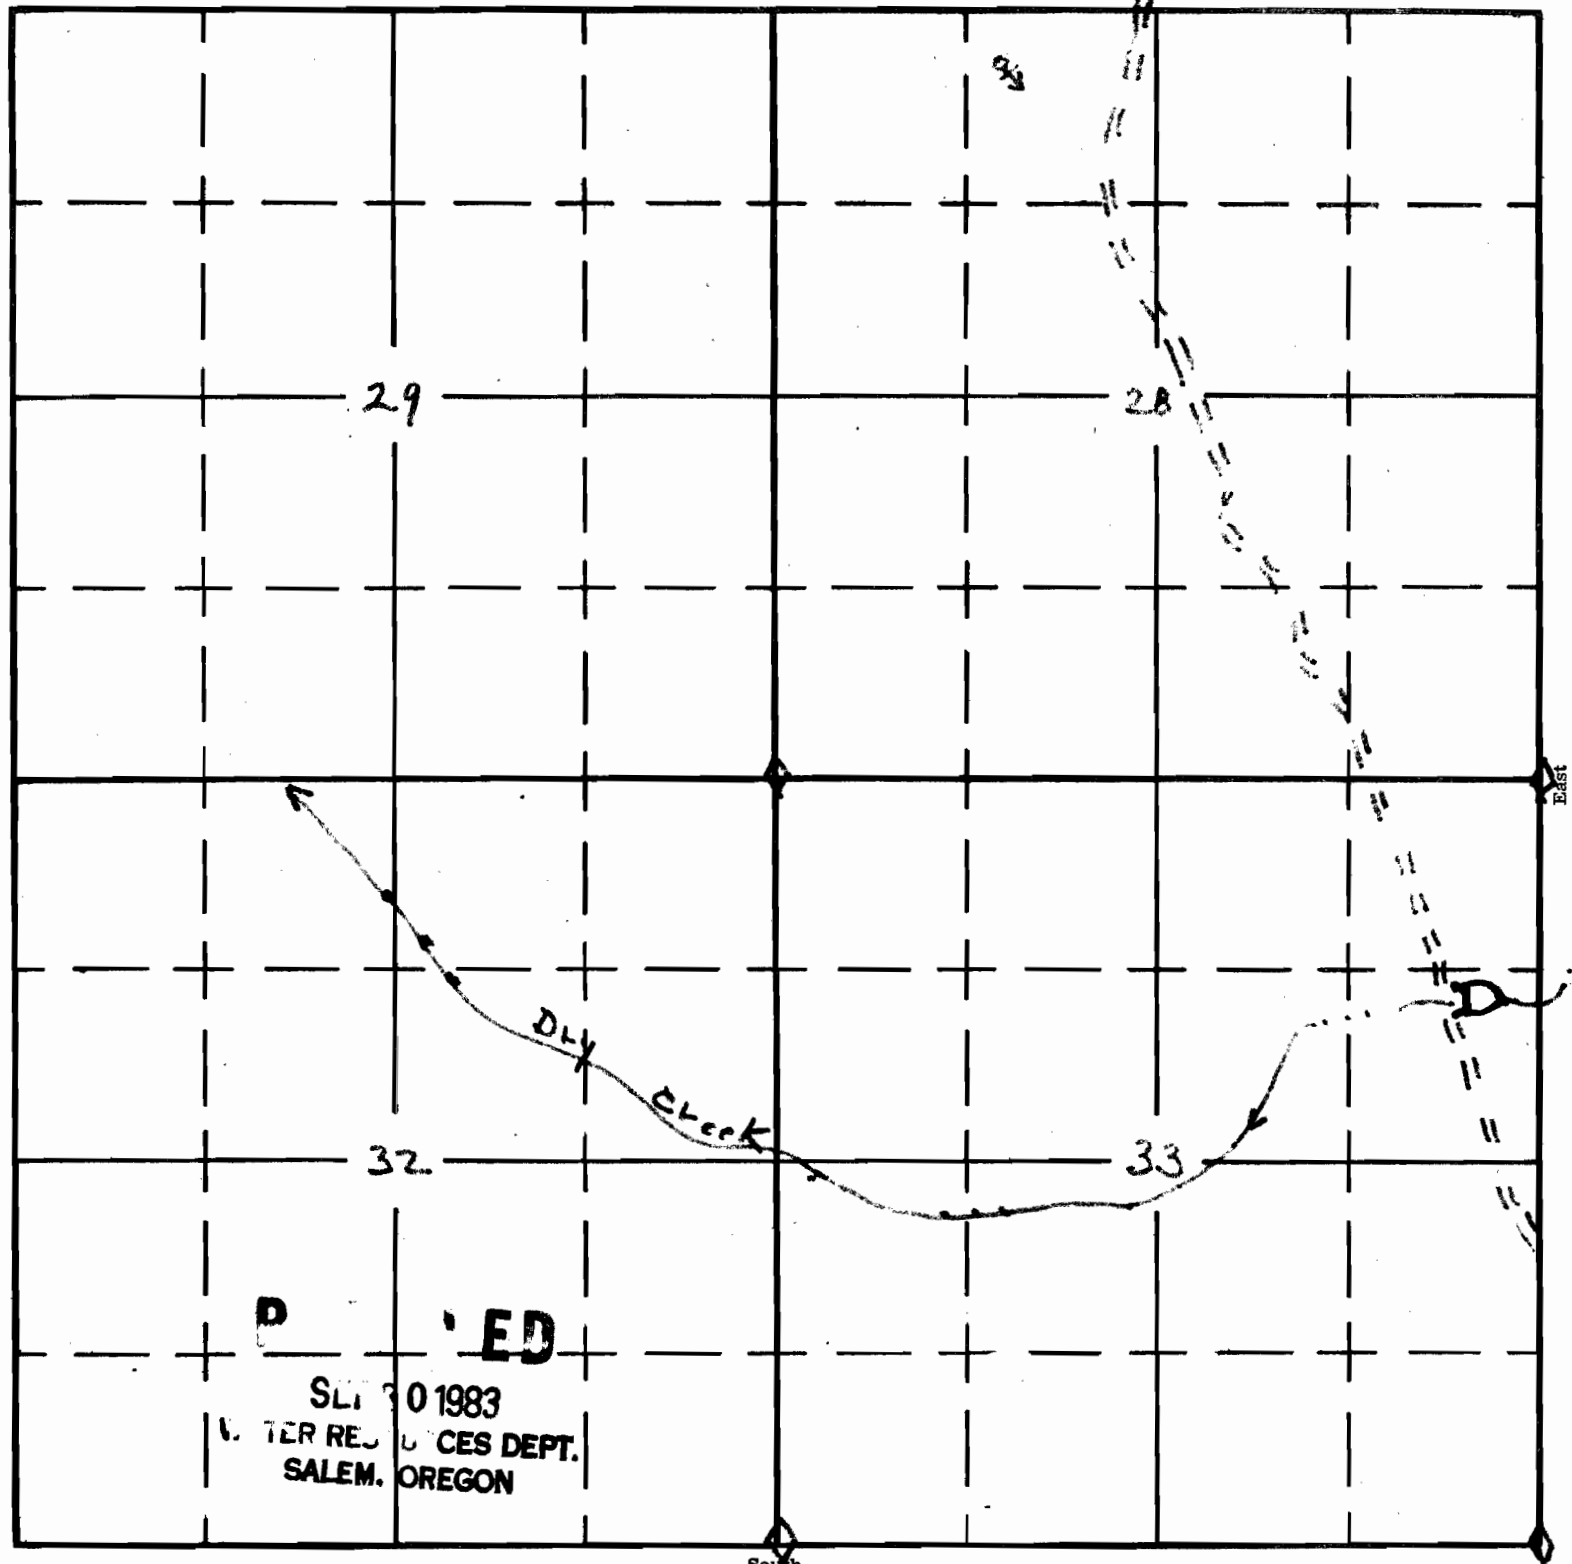

P
ED
SL 30 1983
WATER RESOURCES DEPT.
SALEM, OREGON

Application No. R-67046
Permit No. R10371