


UNITED STATES
DEPARTMENT OF THE INTERIOR
BUREAU OF LAND MANAGEMENT

SECTION
28

Oregon State Water Filings

TOWNSHIP 18S, RANGE 35E, W. M.

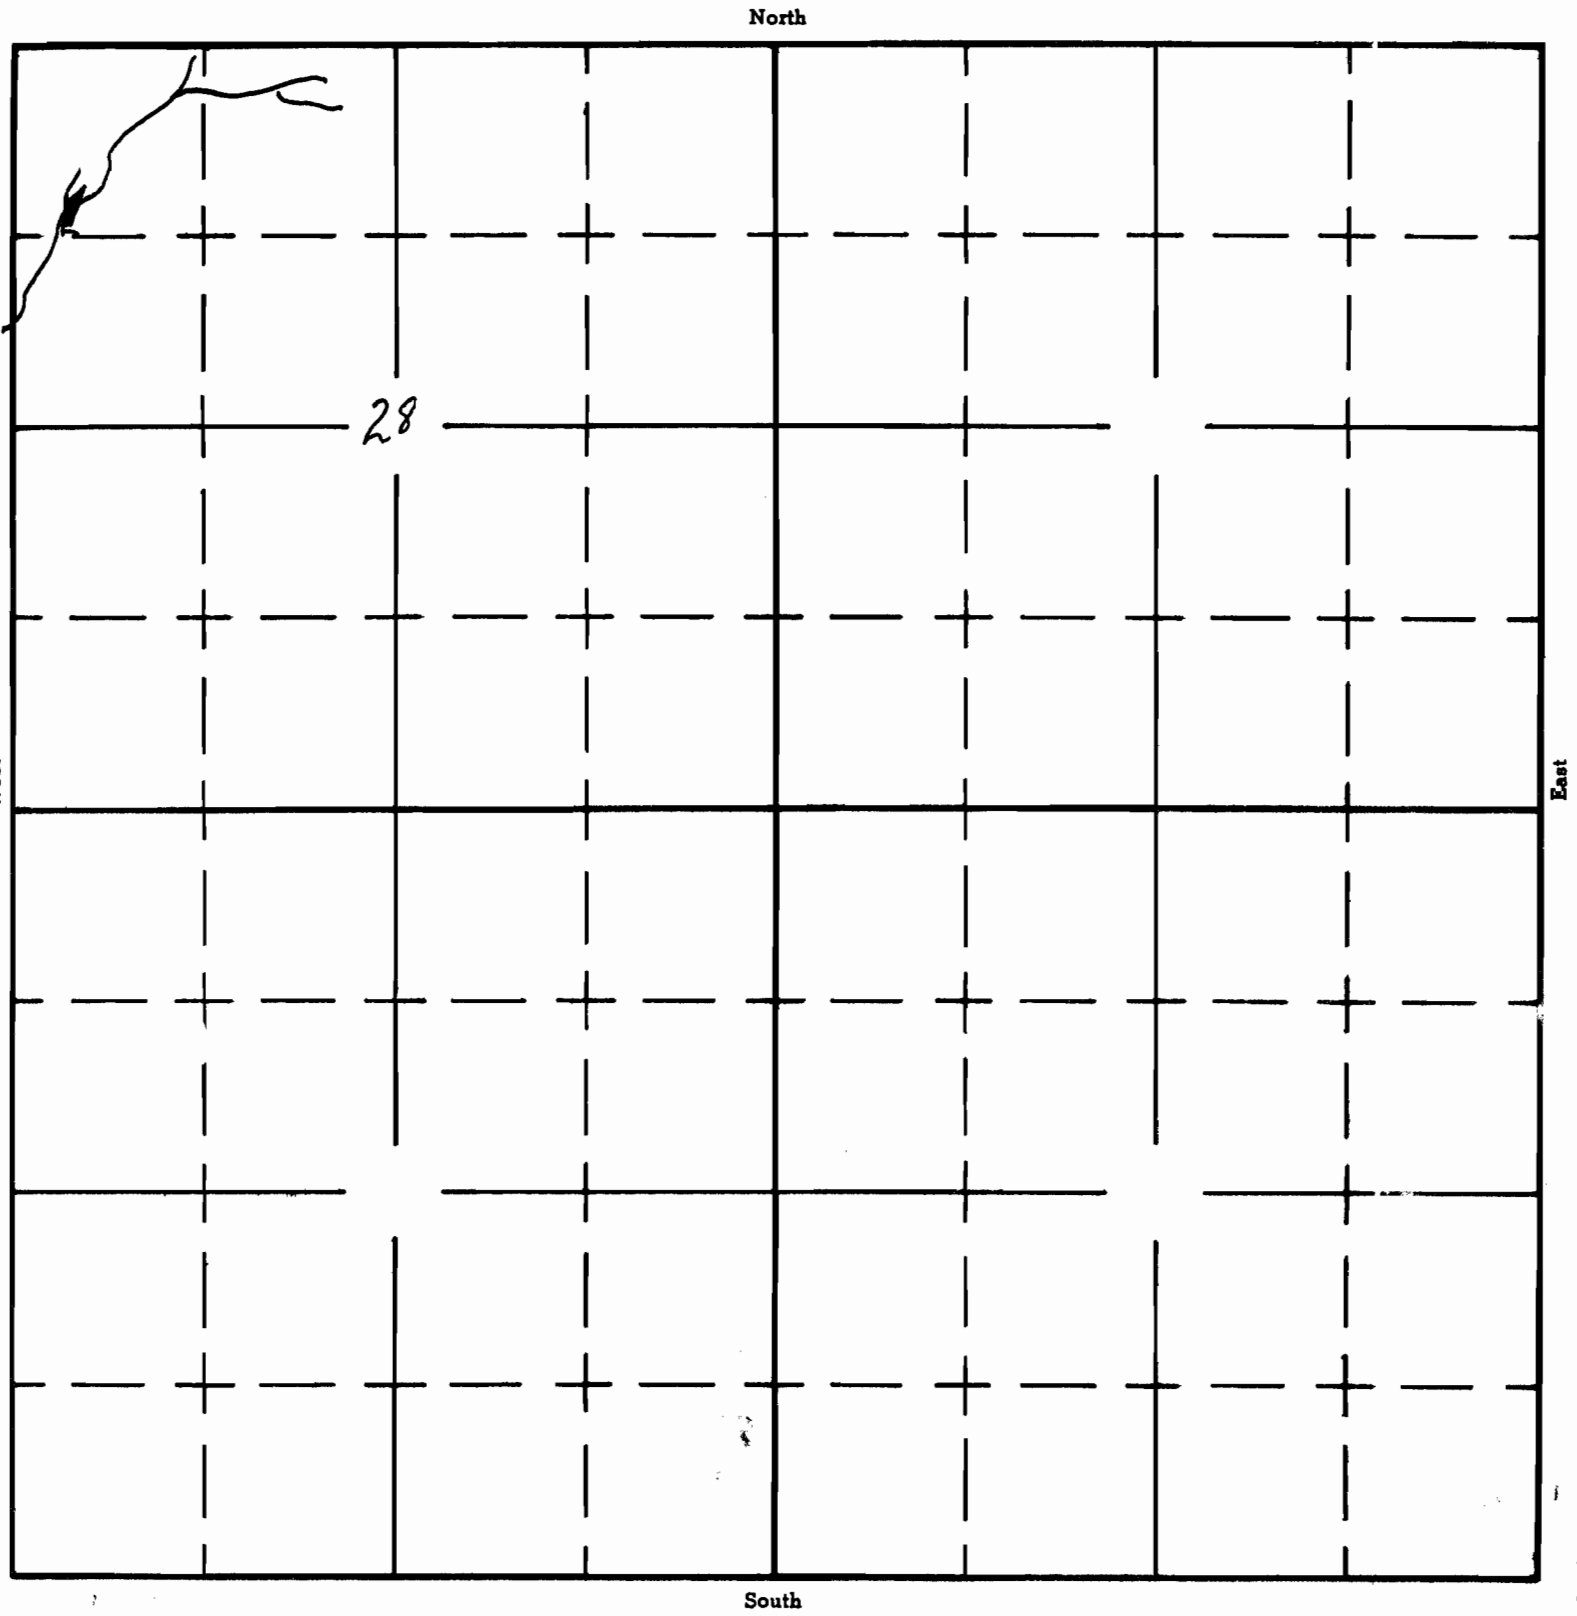

APPLICATION No. R-35445
PERMIT No. R10888