

UNITED STATES
DEPARTMENT OF THE INTERIOR
BUREAU OF LAND MANAGEMENT

SECTION


NE 1/4 SW 1/4

Oregon State Water Filings

28

TOWNSHIP 18S, RANGE 35E, W. M.

North

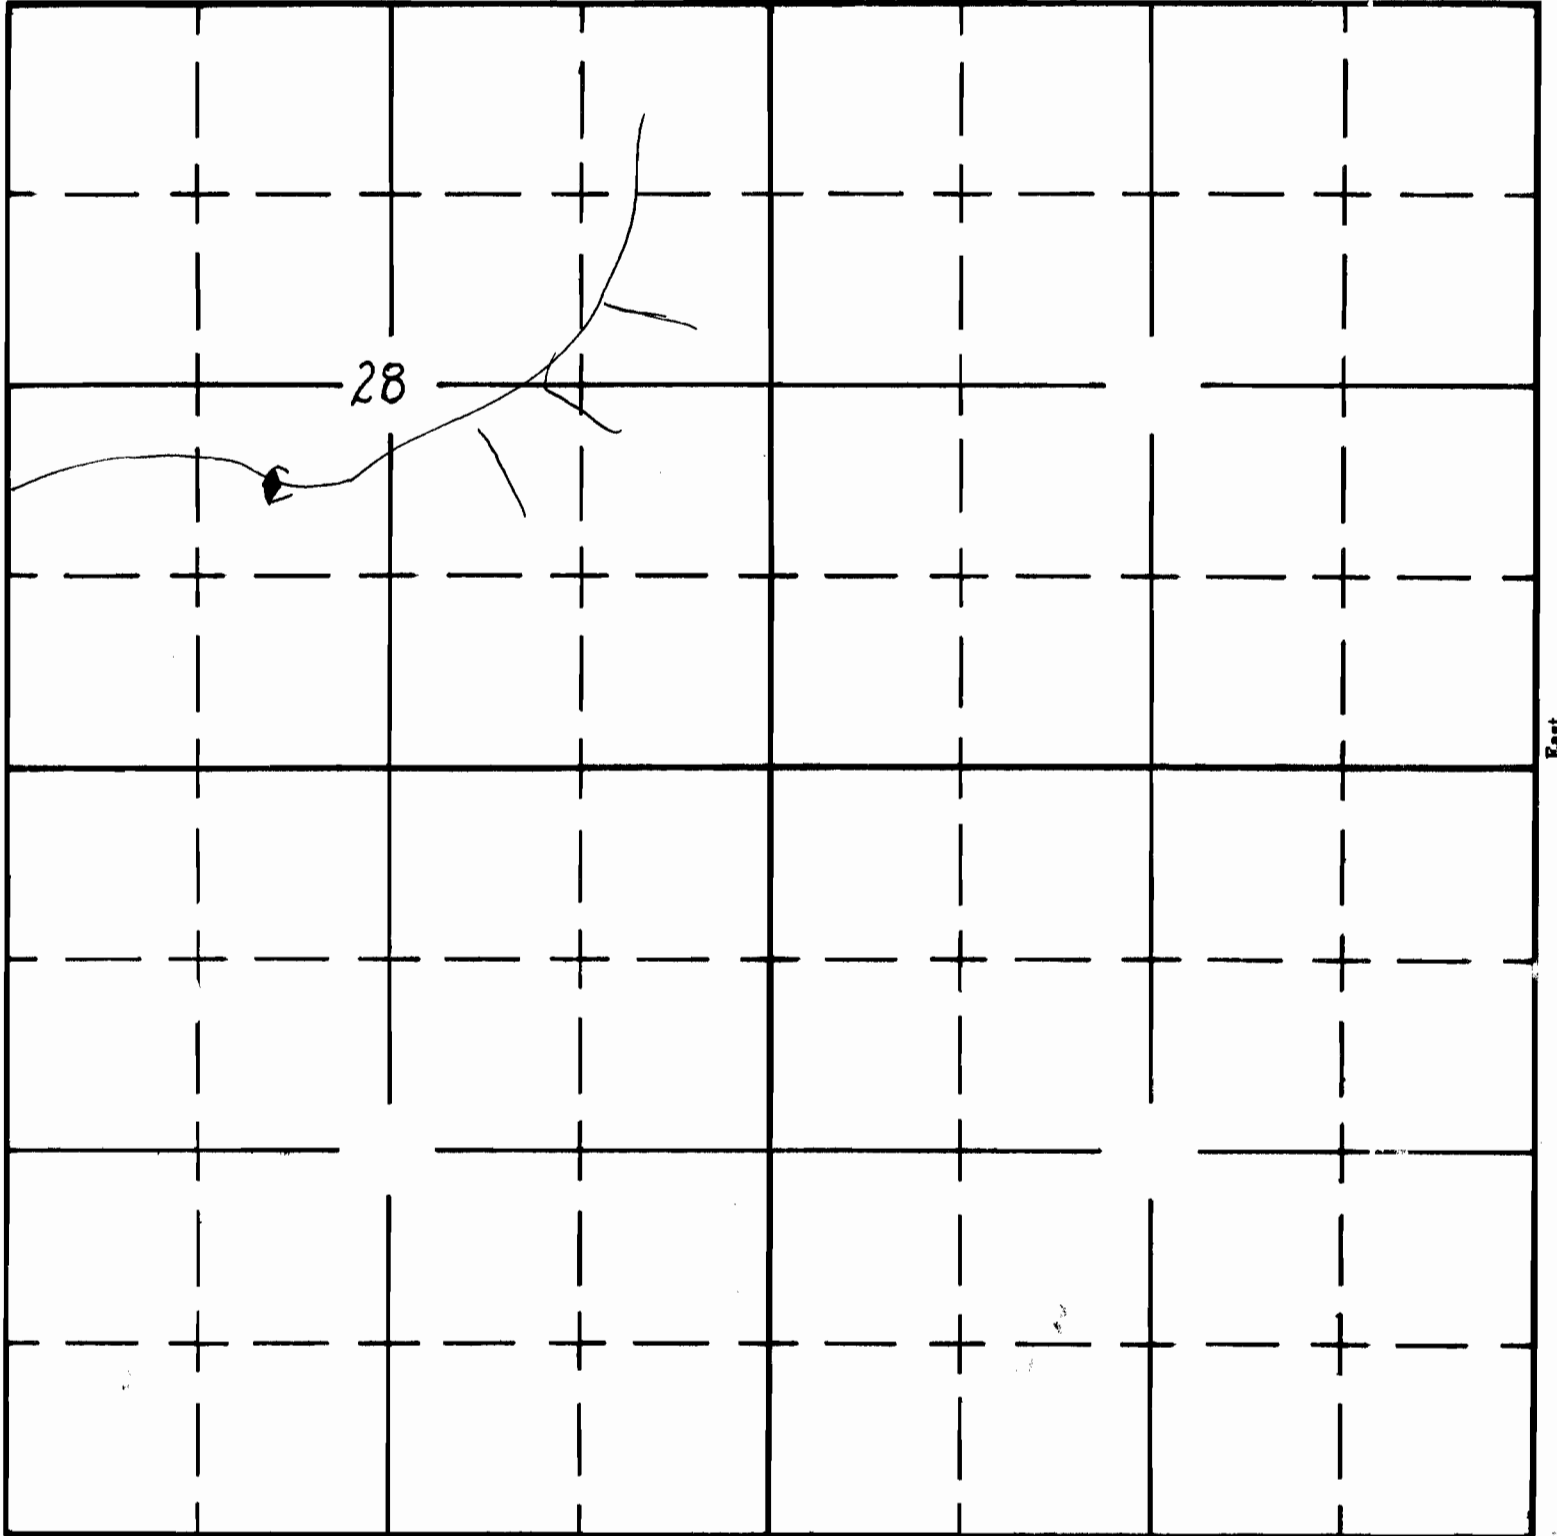

South

APPLICATION No. R-35446
PERMIT No. H-10000