orm A1-187
larch 1961

UNITED STATES
DEPARTMENT OF THE INTERIOR
BUREAU OF LAND MANAGEMENT

SECTION SW¼ NW¼

23

Oregon State Water Filings

TOWNSHIP 18S, RANGE 35E, W. M.

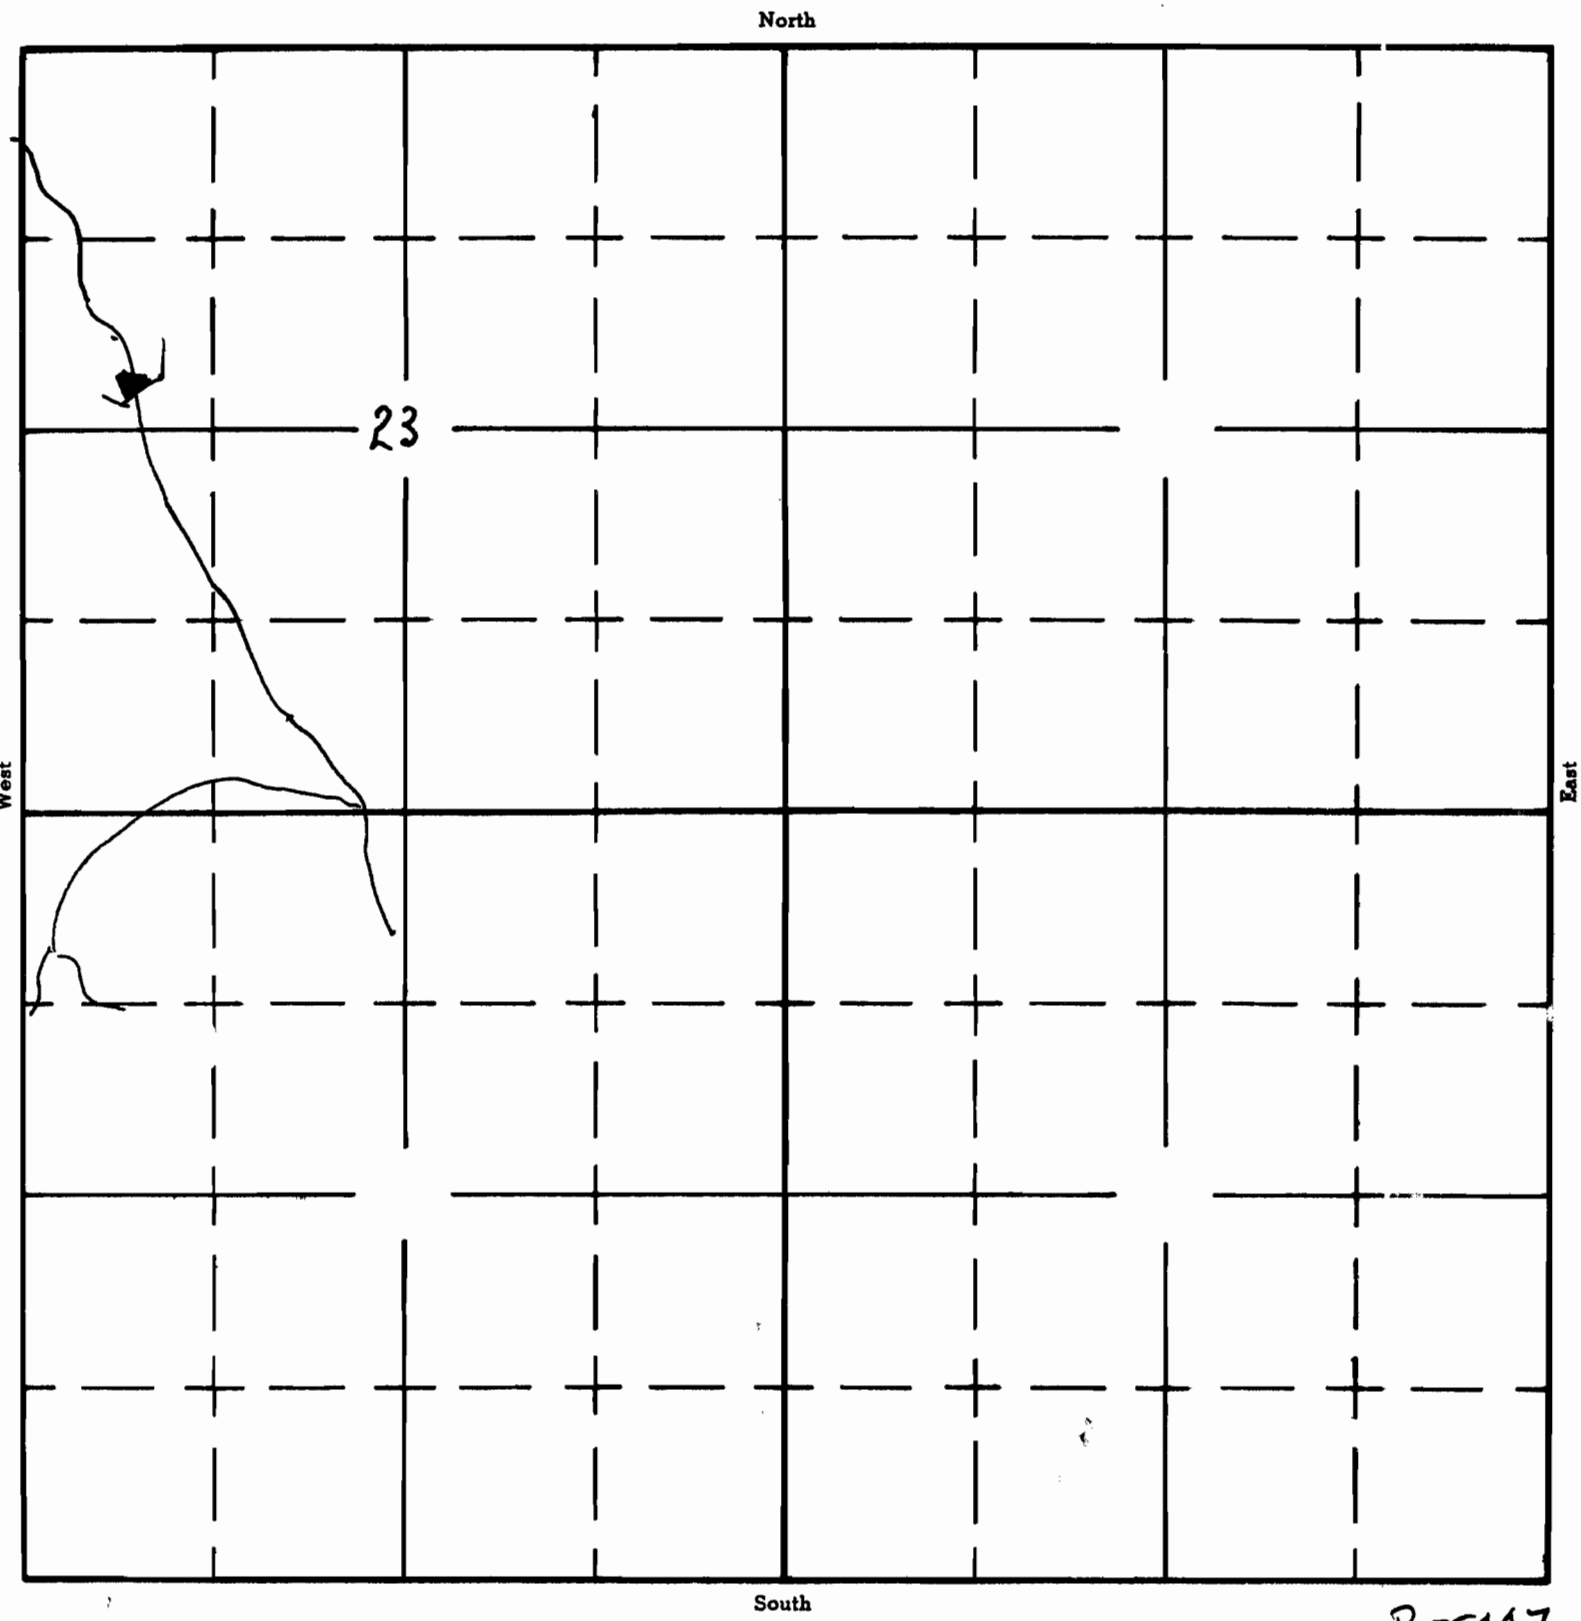

APPLICATION No. R-35447
PERMIT No. [redacted]