

Form A1-187
March 1961

UNITED STATES
DEPARTMENT OF THE INTERIOR
BUREAU OF LAND MANAGEMENT

SECTION


NE $\frac{1}{4}$ SW $\frac{1}{4}$

SEC. 17

Oregon State Water Filings

TOWNSHIP 20 S, RANGE 34 E, W. M.

North

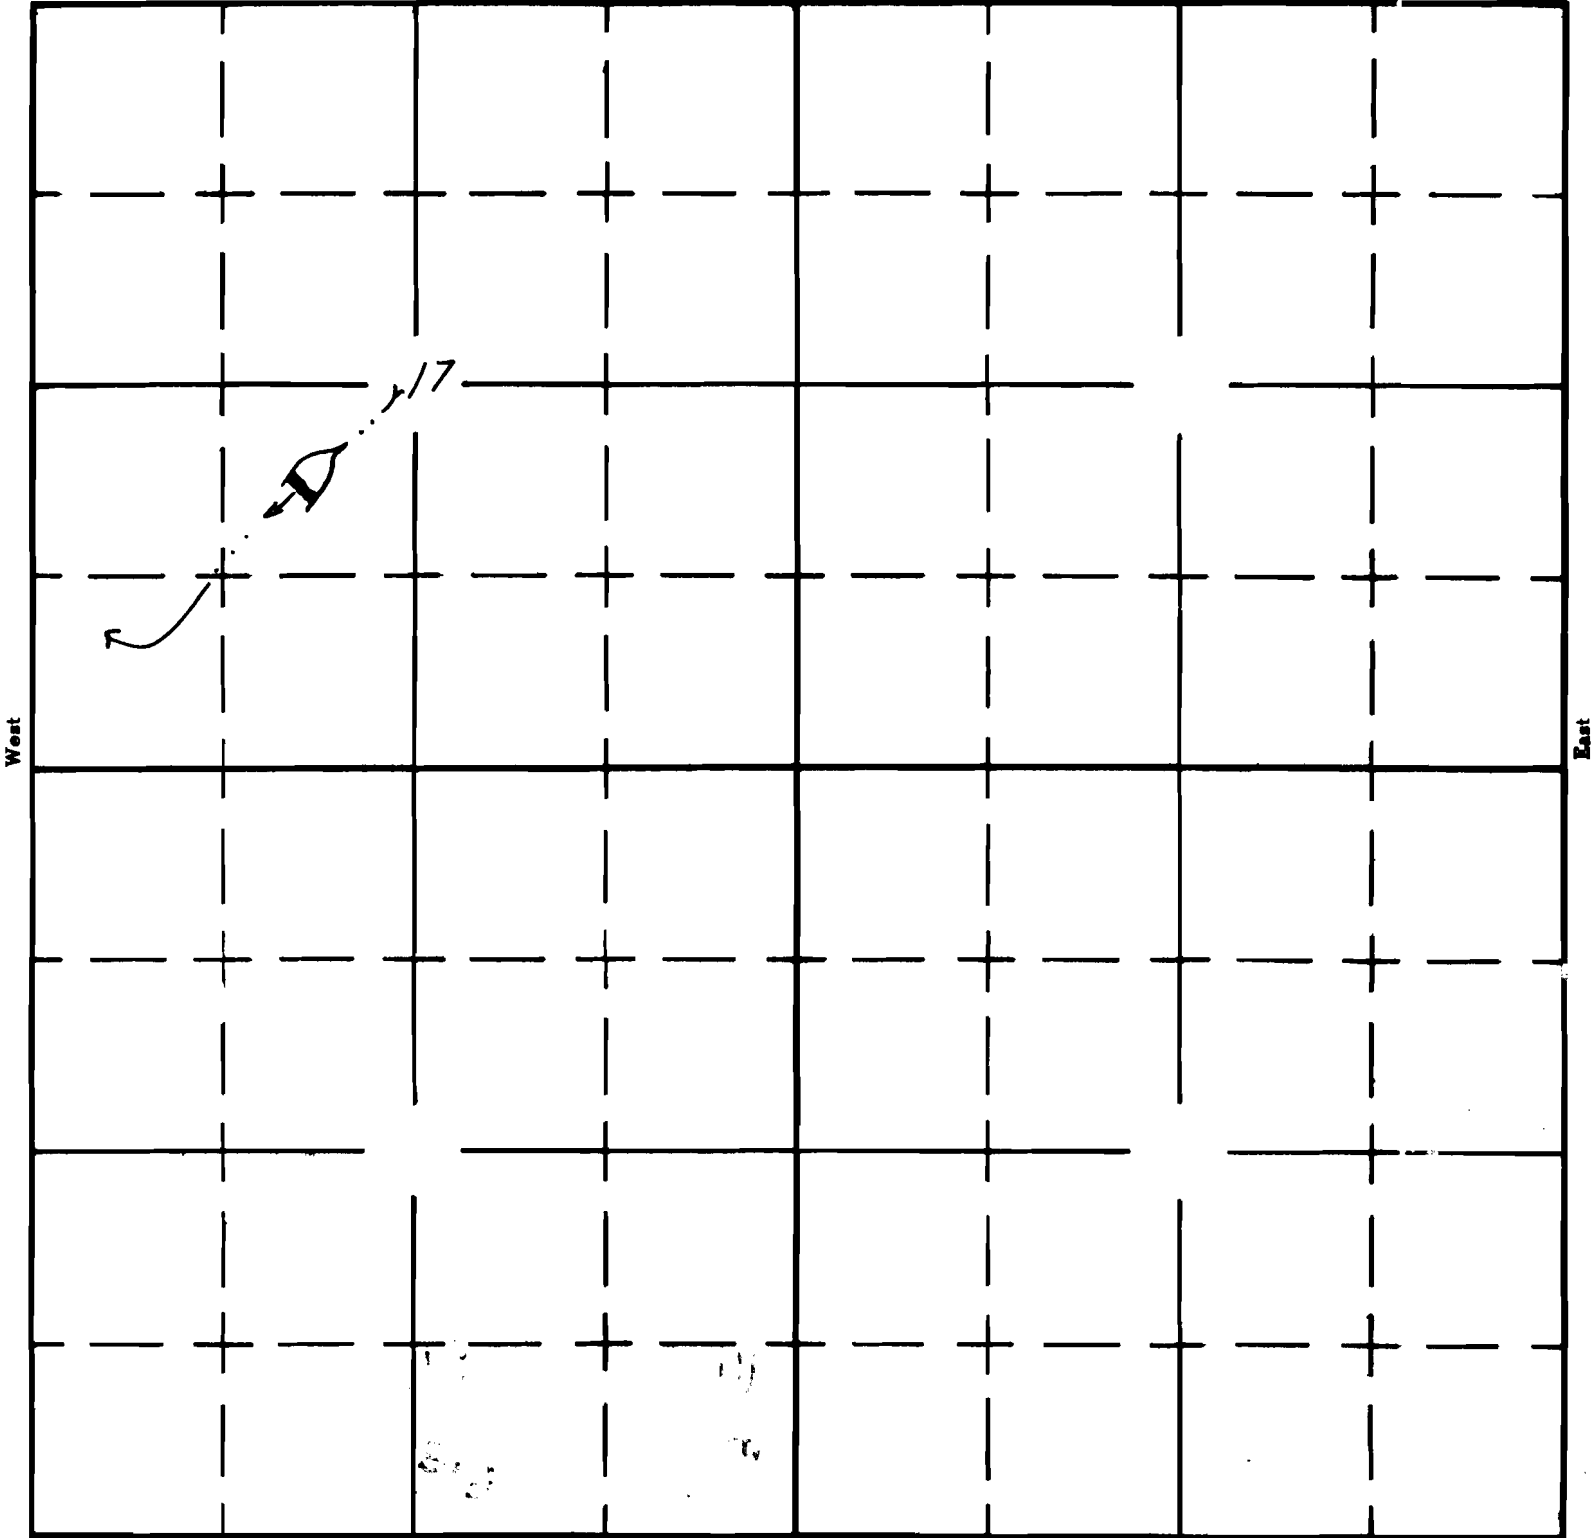

South

APPLICATION No. D-35631
PERMIT No. 210703