

UNITED STATES
DEPARTMENT OF THE INTERIOR
BUREAU OF LAND MANAGEMENT

SECTION


NE $\frac{1}{4}$ NW $\frac{1}{4}$

Oregon State Water Filings

SEC. 12

TOWNSHIP 21 S, RANGE 36 E, W. M.

North

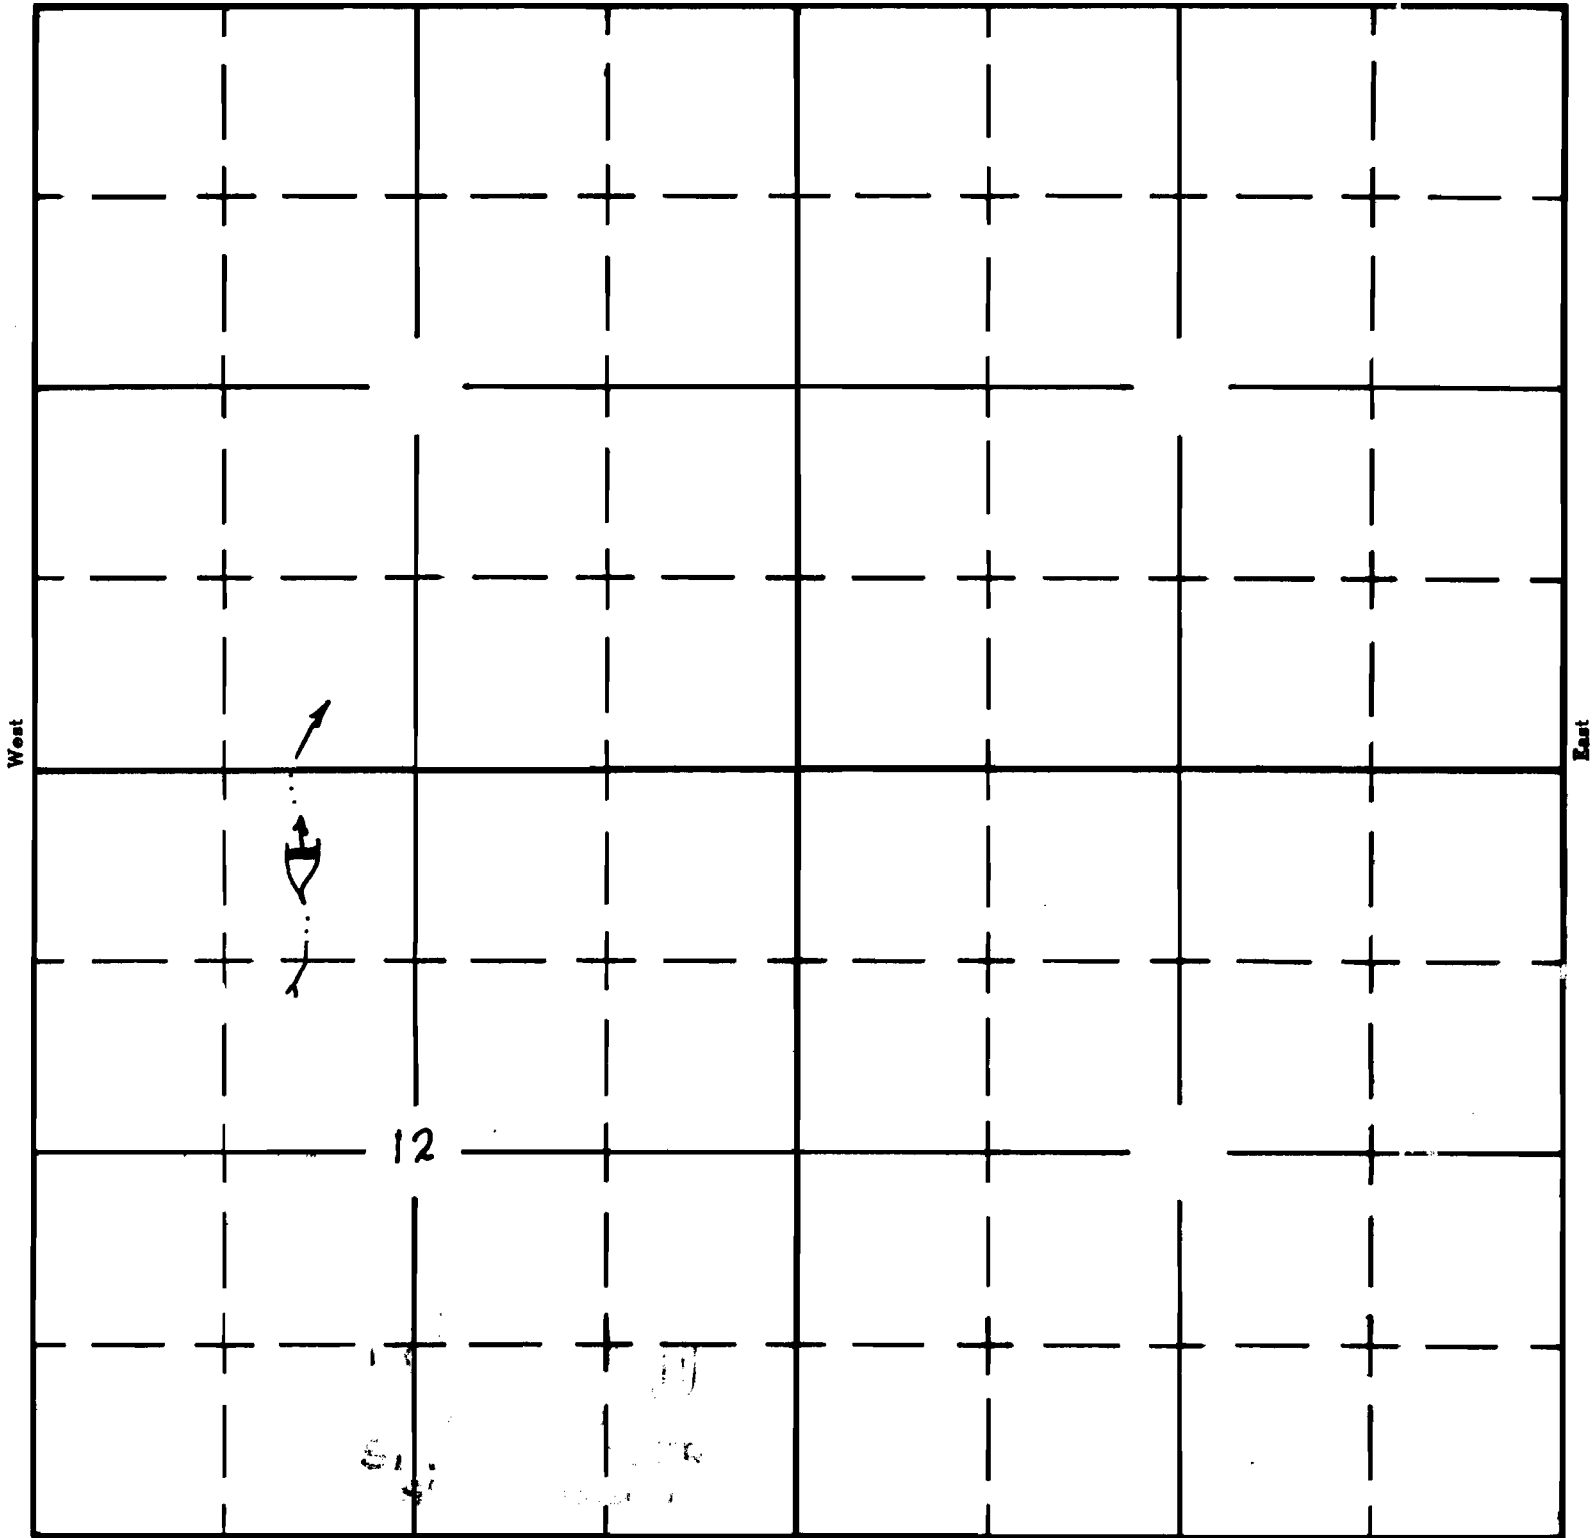

South

APPLICATION No. D-35673
PERMIT No. B10704