

Form AI-187
March 1961

UNITED STATES
DEPARTMENT OF THE INTERIOR
BUREAU OF LAND MANAGEMENT

SECTION


SE $\frac{1}{4}$ NW $\frac{1}{4}$

SEC 24

Oregon State Water Filings

TOWNSHIP 19 S, RANGE 36 E, W. M.

North

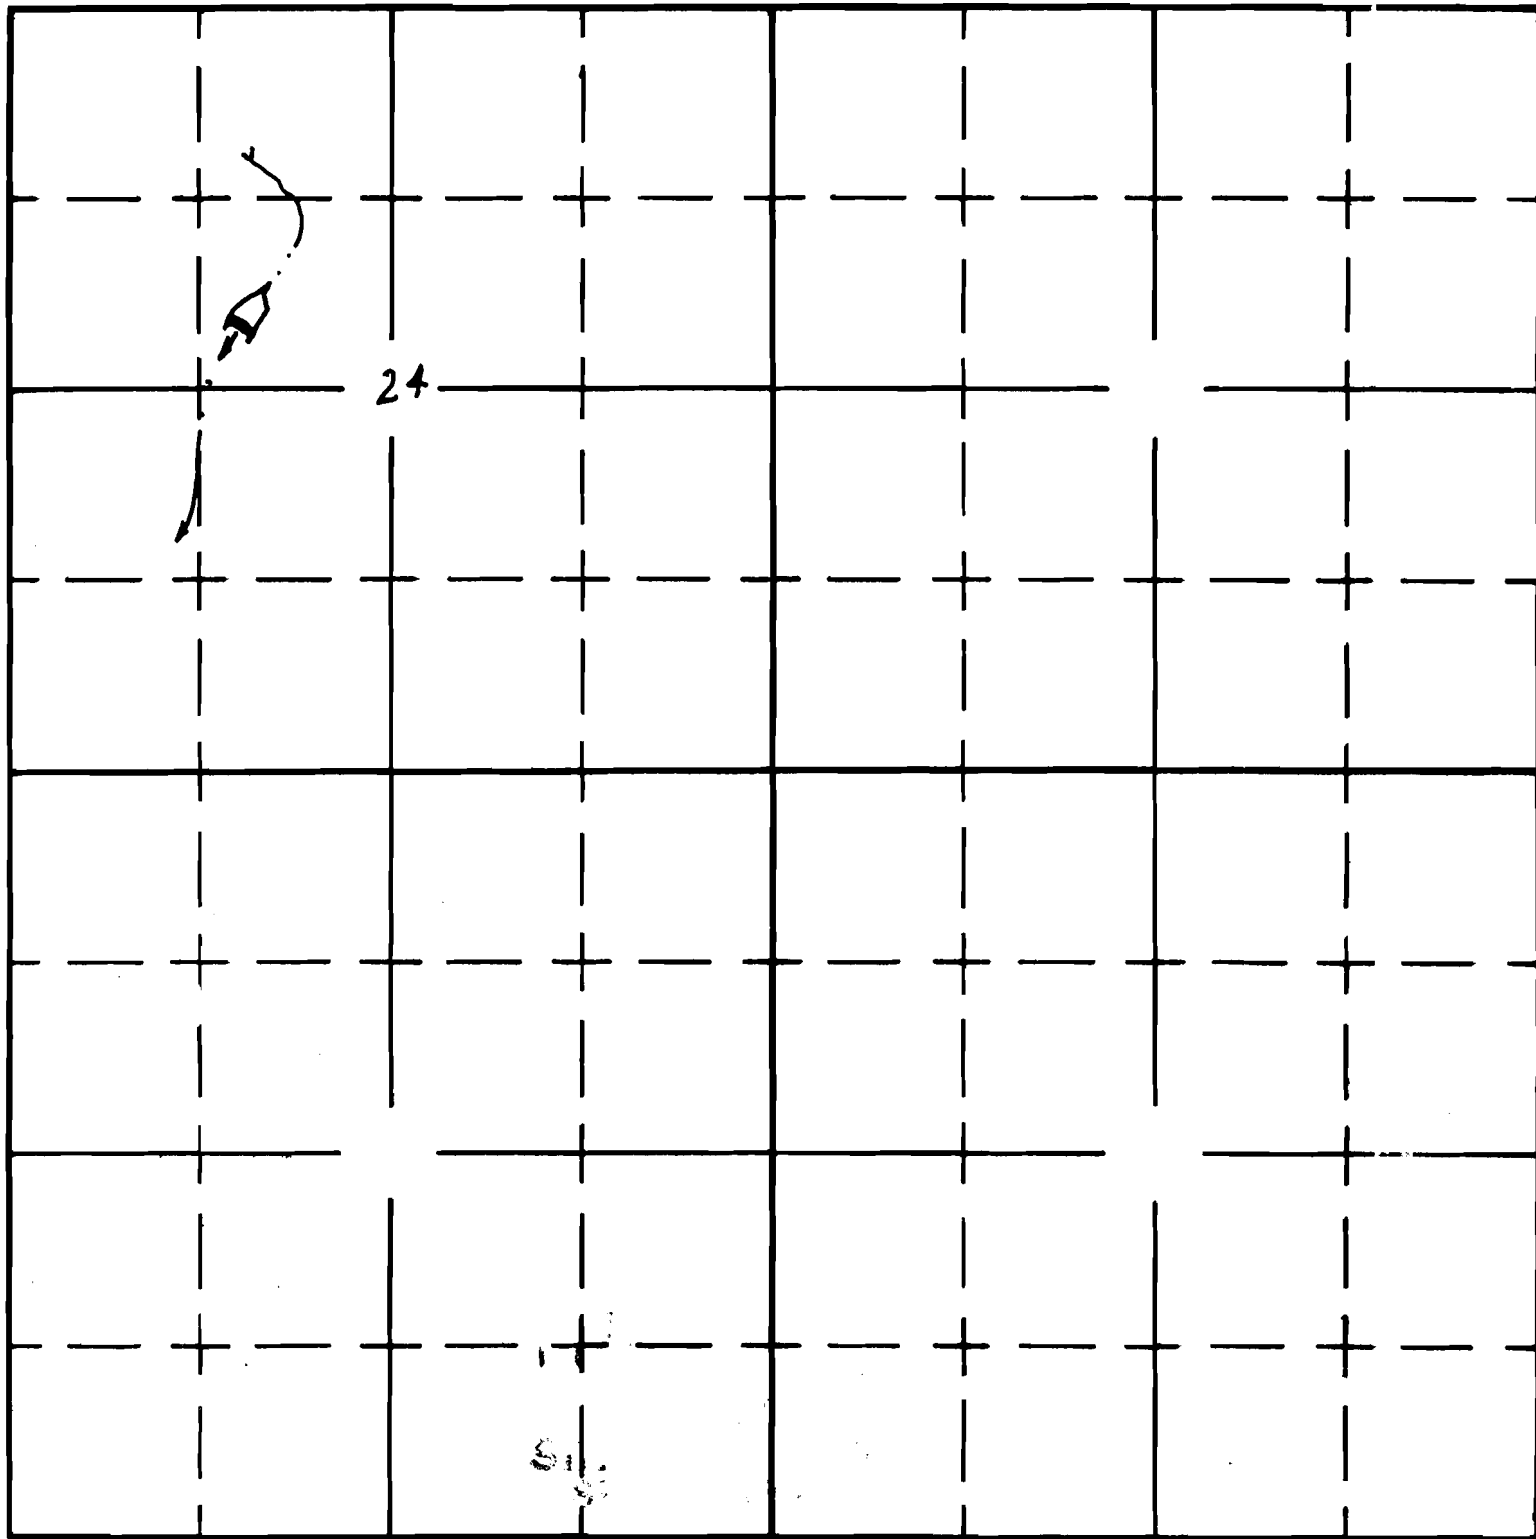

South

APPLICATION No. R-35674
PERMIT No. R10703