

UNITED STATES
DEPARTMENT OF THE INTERIOR
BUREAU OF LAND MANAGEMENT

SECTION


NW 1/4 NW 1/4

Oregon State Water Filings

25

TOWNSHIP 20S, RANGE 34E, W. M.

North

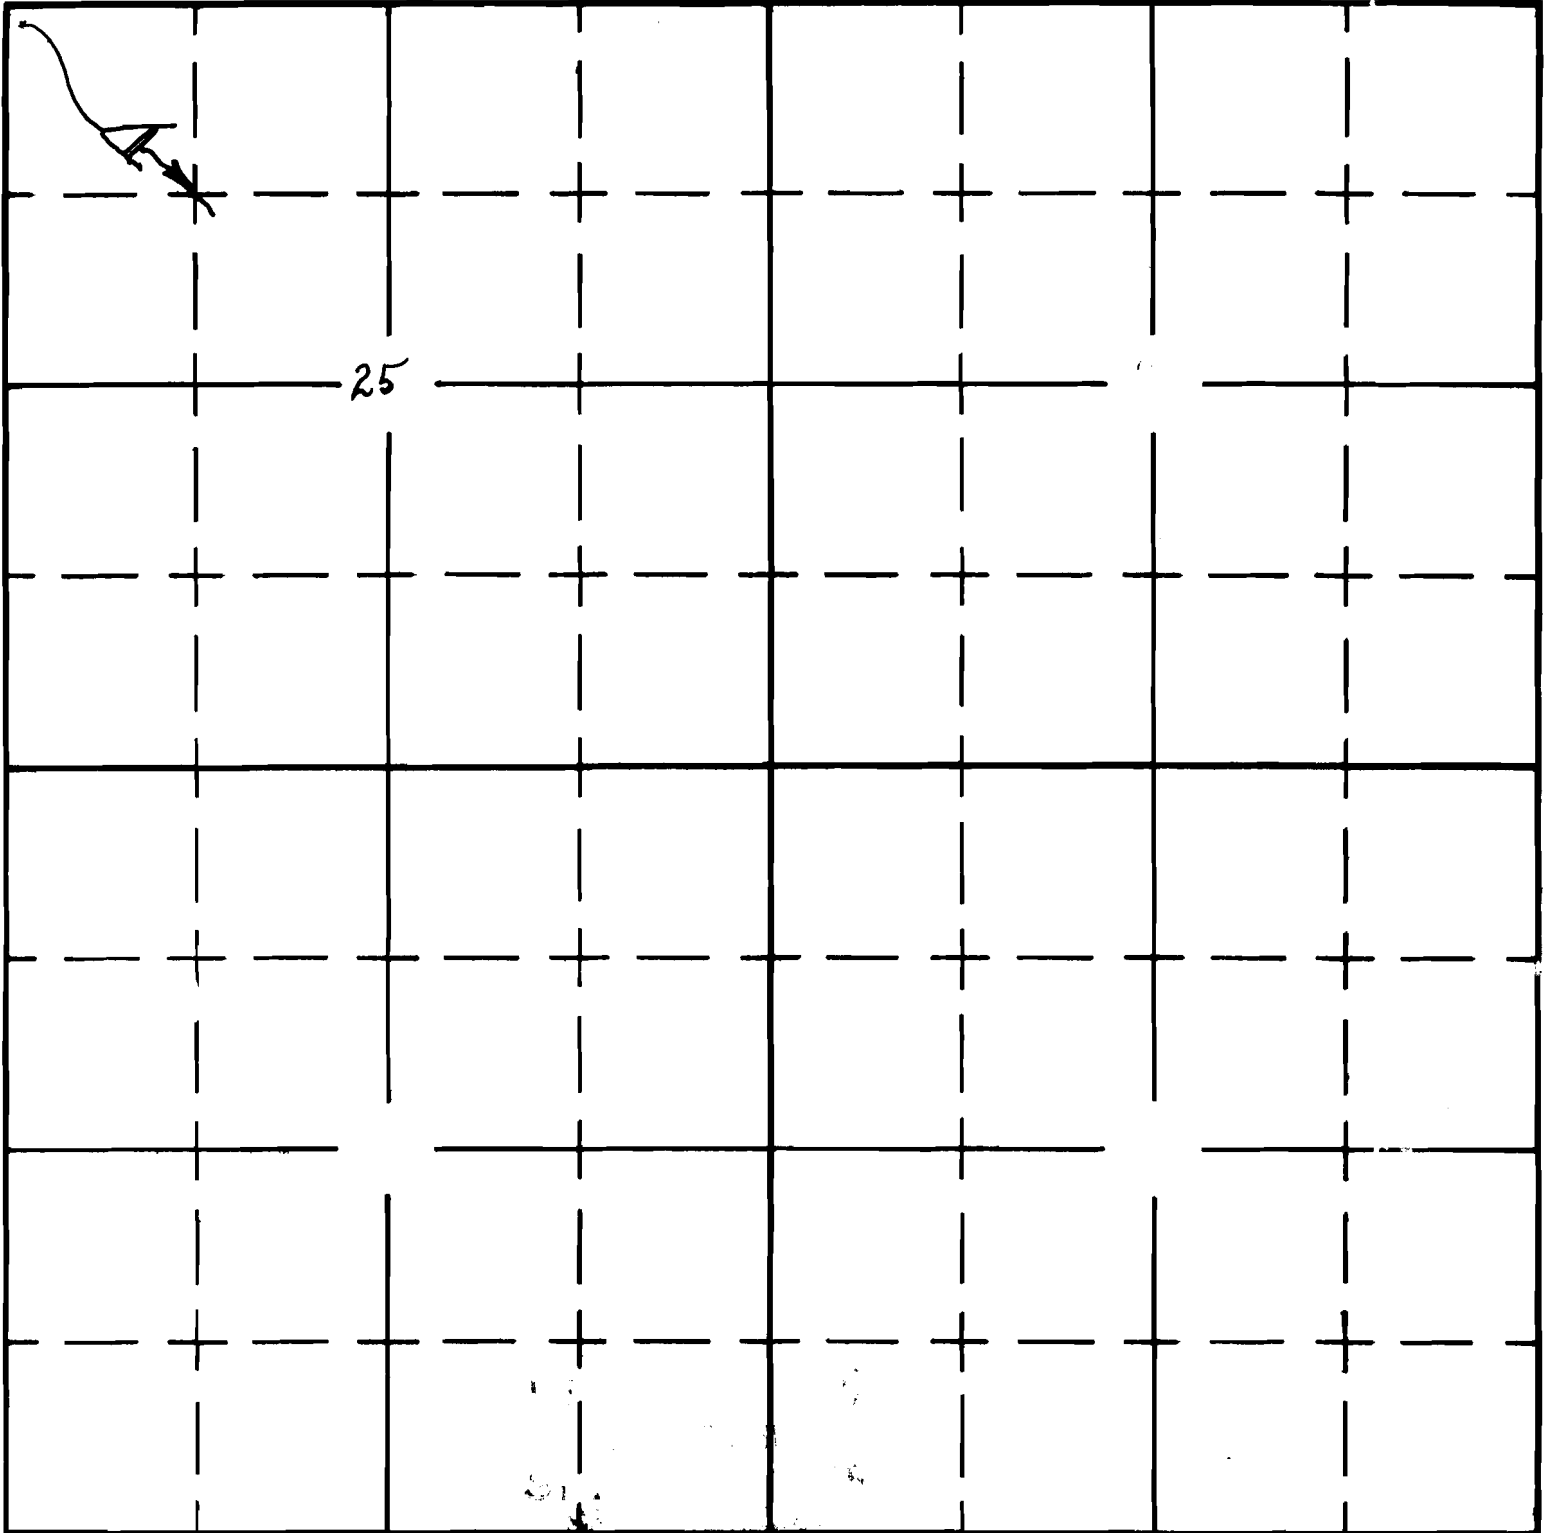

South

APPLICATION No. R-35675
PERMIT No. 810706