

UNITED STATES
DEPARTMENT OF THE INTERIOR
BUREAU OF LAND MANAGEMENT


SECTION

NW 1/4 NE 1/4 Oregon State Water Filings

35

TOWNSHIP 19S, RANGE 36E, W. M.

North

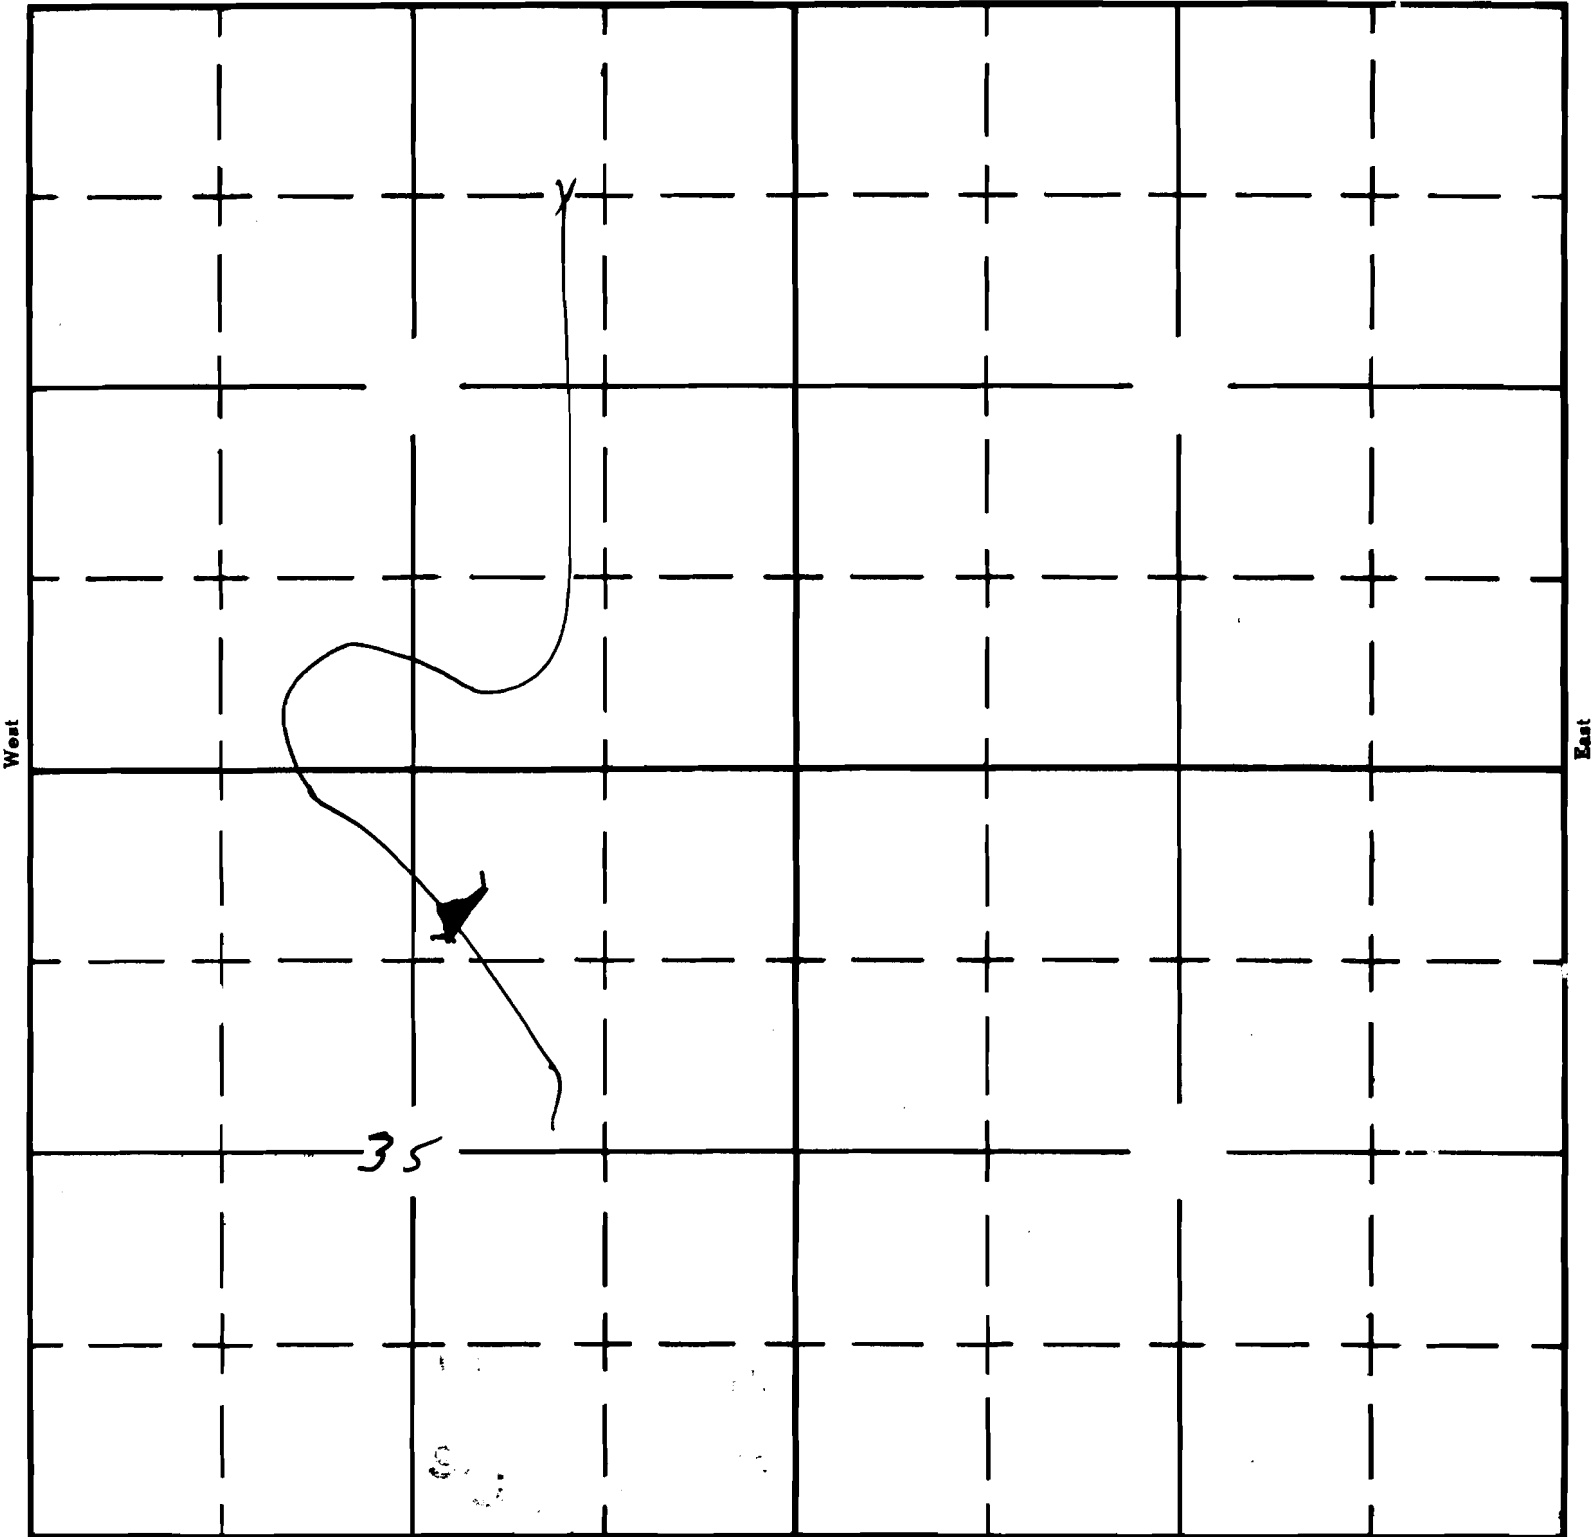

South

APPLICATION No. R-35700
PERMIT No. R10708