

Form A1-187
March 1961

UNITED STATES
DEPARTMENT OF THE INTERIOR
BUREAU OF LAND MANAGEMENT

SECTION


SE 1/4 NE 1/4

Oregon State Water Filings

Sec 9

TOWNSHIP 19S, RANGE 35E, W. M.

North

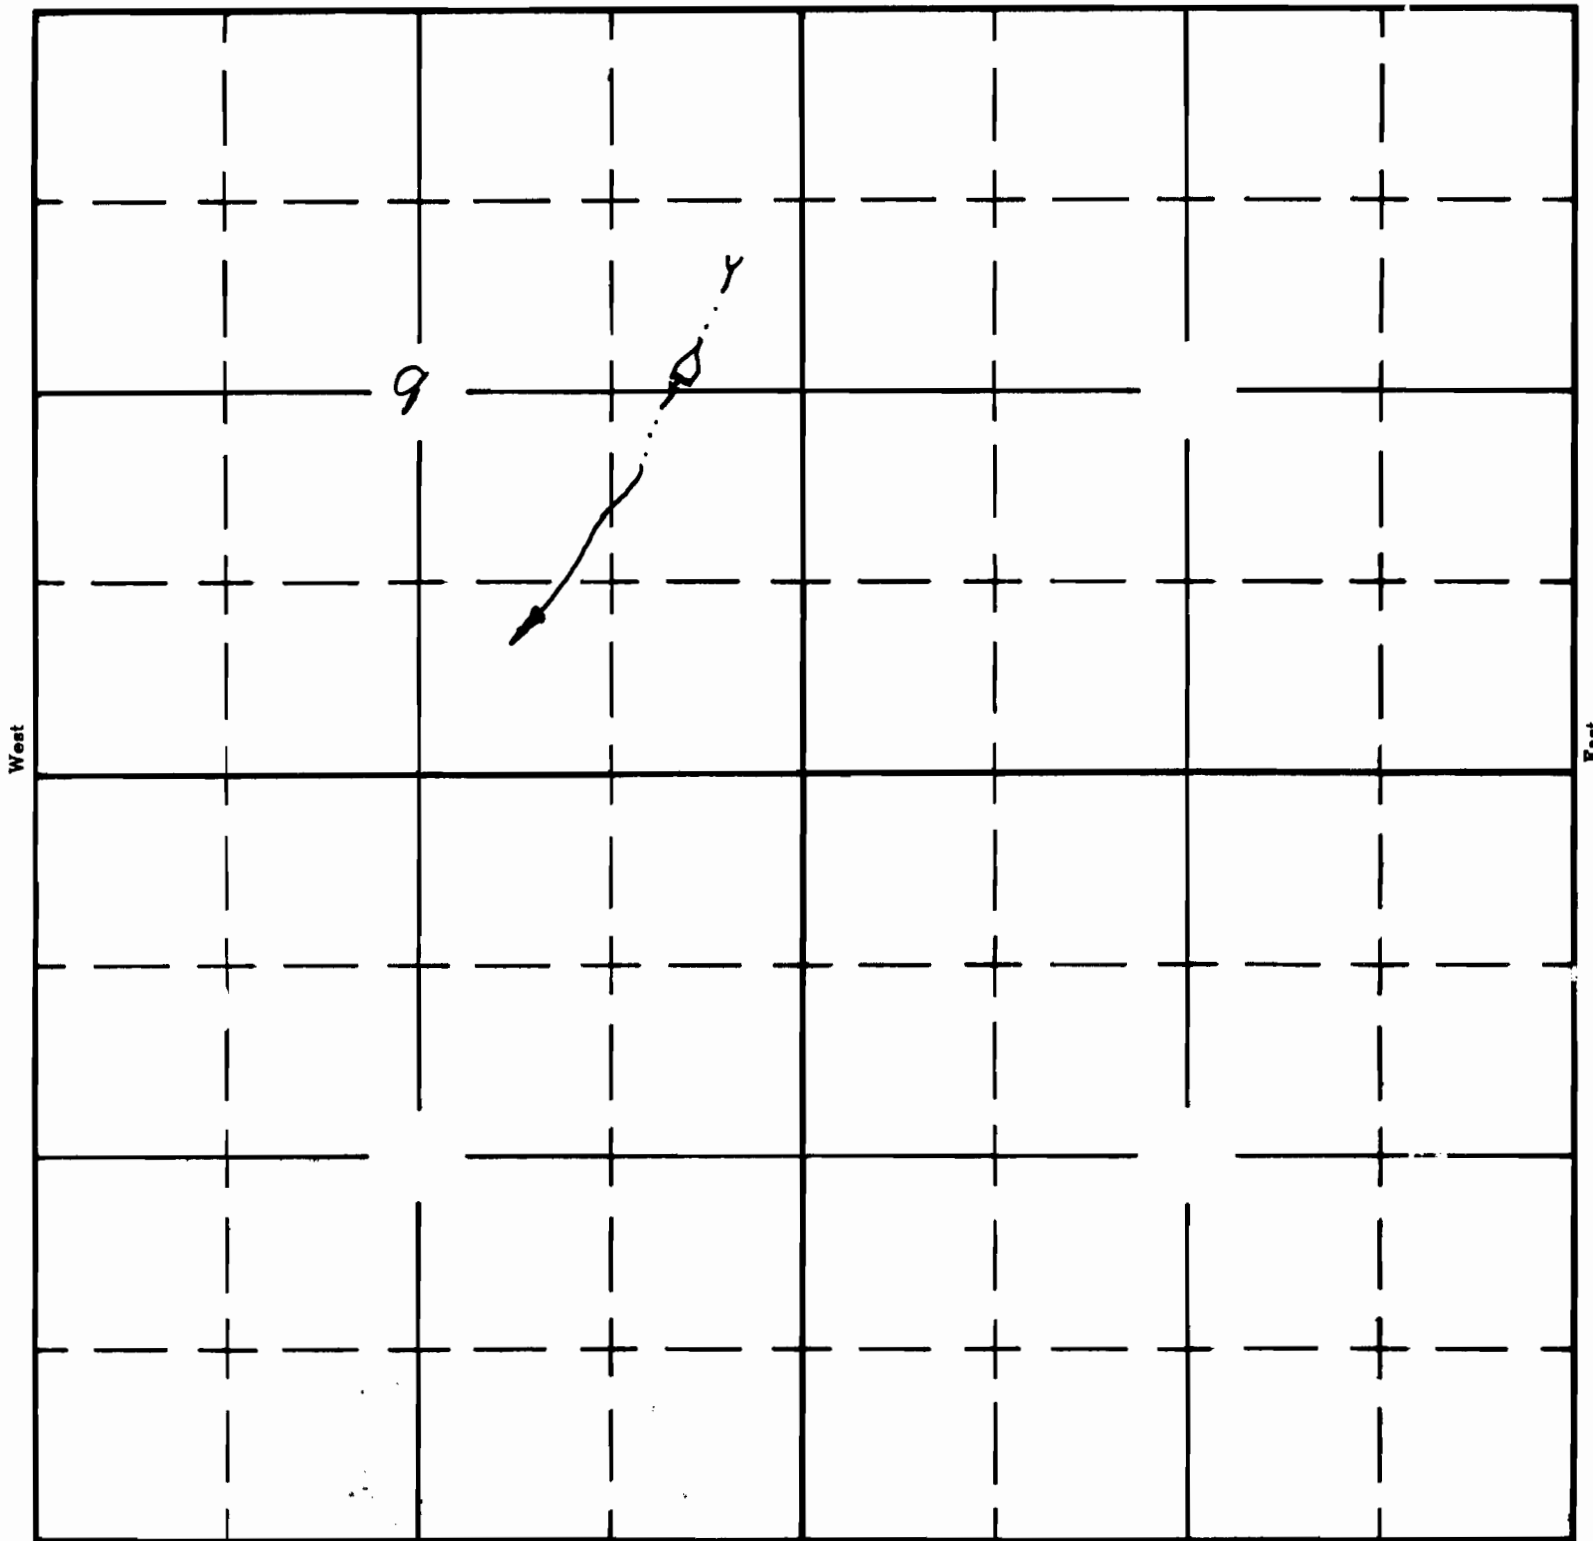

South

APPLICATION No. R-35710
PERMIT No. R10710