


G-6956
T7984
51012
79084

T40S. R18 & 19E. WM.

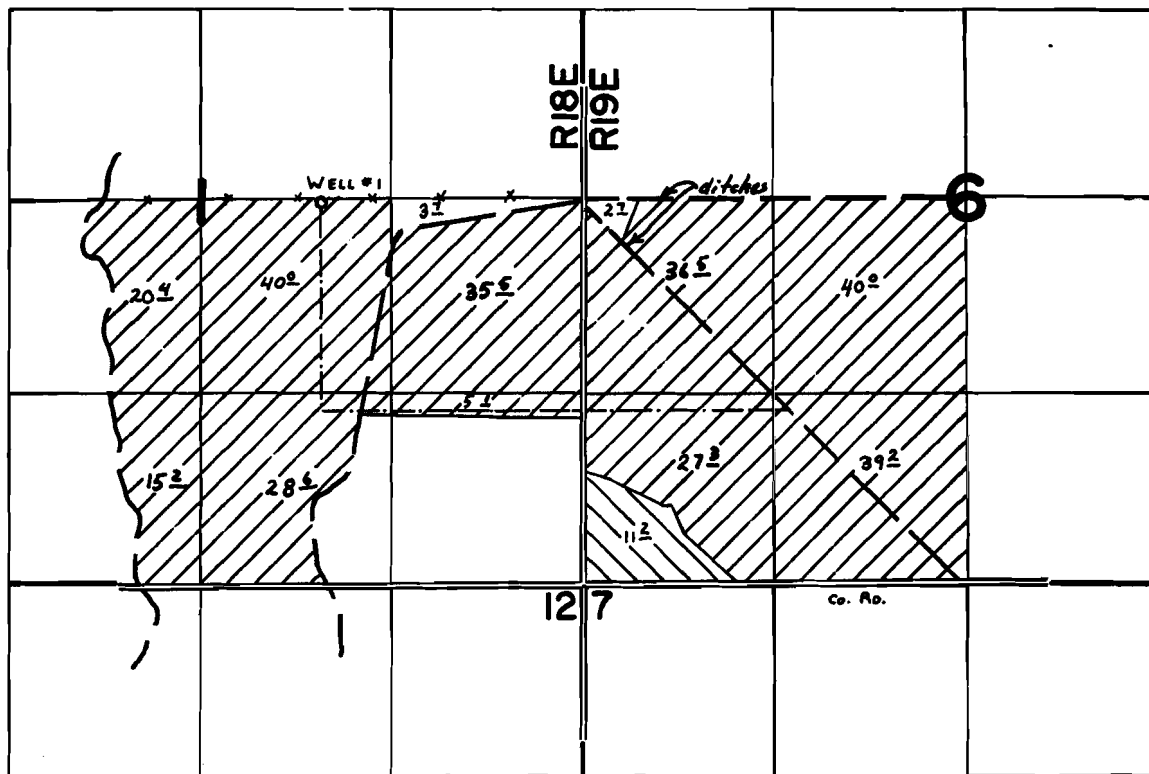

WELL LOC: 2630' N. & 1820' W. fr. SE. Cor. Sec. 1.

- ▨ - SUPPLEMENTAL IRRIGATION
- ▨ - PRIMARY IRRIGATION

FINAL PROOF SURVEY UNDER

Application No. G-7472 Permit No. G-6956
IN NAME OF

Portello Ranch Company, Inc.

Surveyed JUNE 24 1978, by C. L. HUGHES