





G 8101  
 (G-9464)  
 62677  
 79085  
 T7984

T.40 S., R.18 E., W. M.

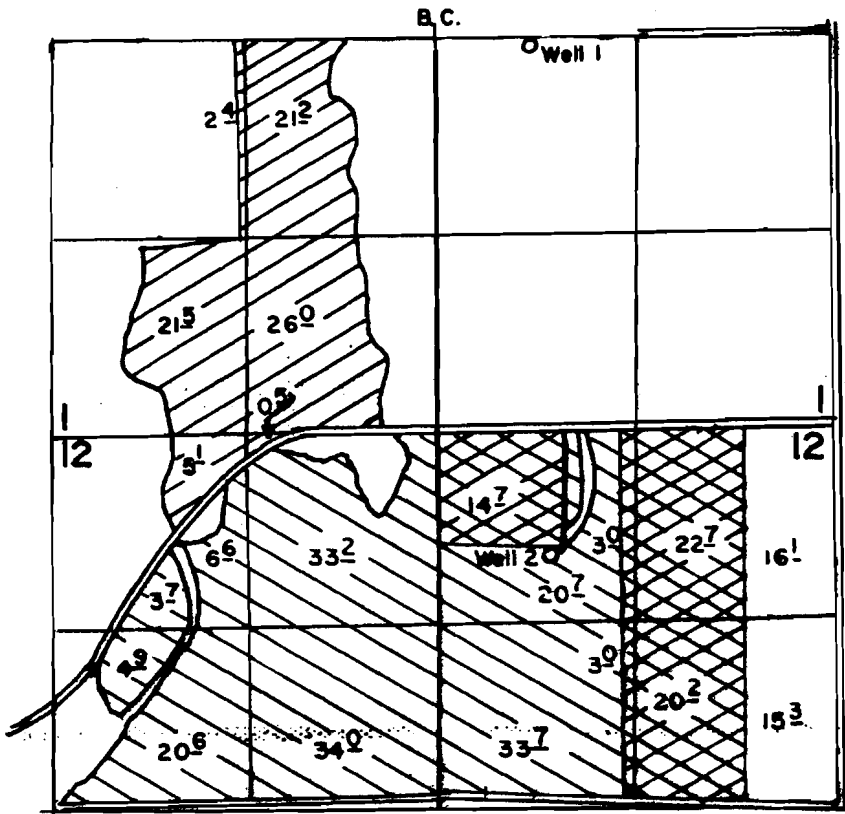

WELL 1 LOC. 40' S. & 650' E. FROM CENTER SECTION 1  
 WELL 2 LOC. 850' S. & 750' E. FROM N 1/4 COR SECTION 12

SCALE: 1"=1320'

	Permit G-8101
	Permit G-9464 Primary
	Permit G-9464 Supplemental

**FINAL PROOF SURVEY**  
 UNDER

G-8738                      G-8101  
 Application No. G-10335... Permit No. G-9464.....  
 IN NAME OF  
 ..PORTELLO RANCH COMPANY INC..  
 Surveyed ..OCT..15.. 19.87., by ..B.S. JAMES.....