


UNITED STATES
DEPARTMENT OF THE INTERIOR
BUREAU OF LAND MANAGEMENT

SECTION

Oregon State Water Filings

TOWNSHIP 21S, RANGE 42E W. M.

12 Stacy Res #2 North

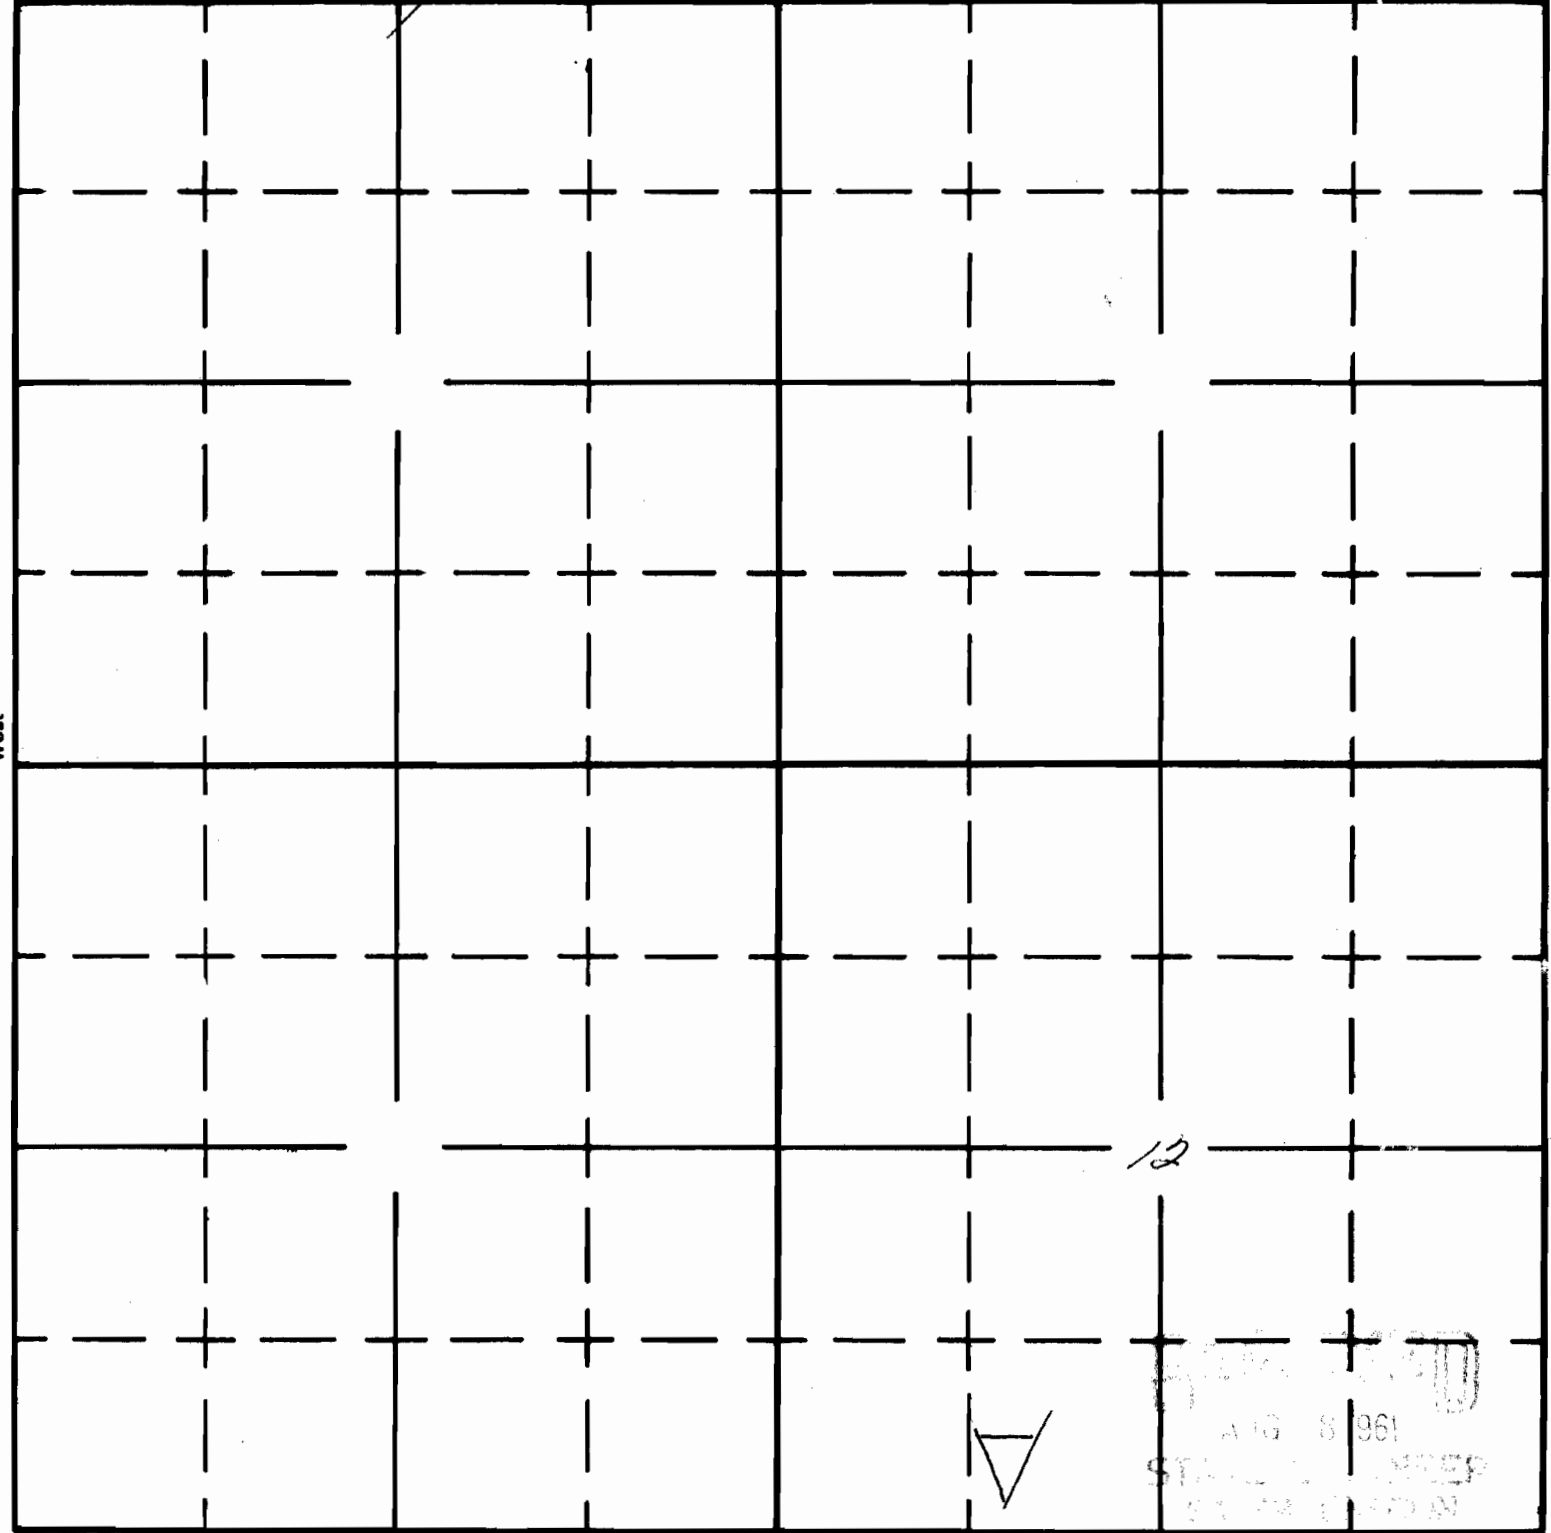

RECEIVED
AUG 8 1961
STACY RES #2
BUREAU OF LAND MANAGEMENT