


T. 3 N.R. 17 E.W.M.

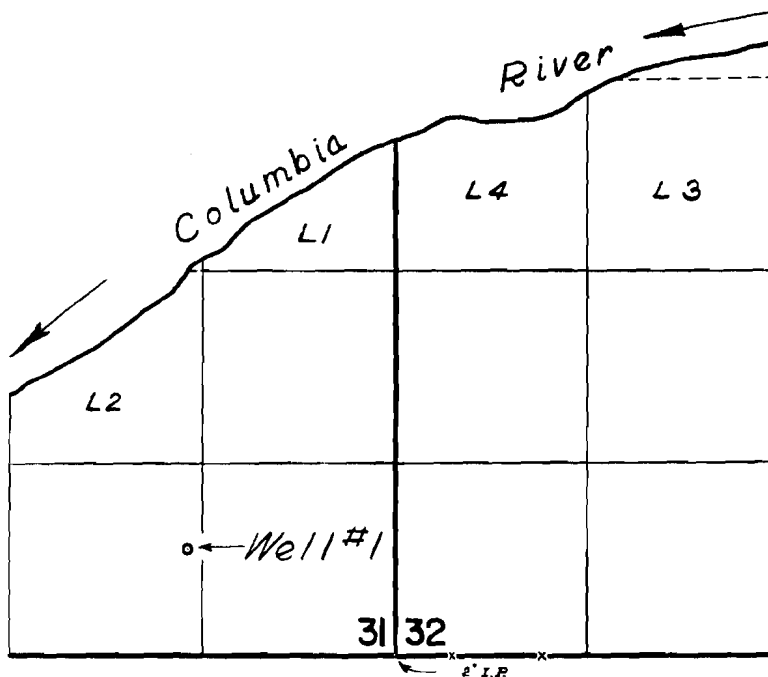

FINAL PROOF SURVEY
UNDER

Application No. G-250 Permit No. G-199
IN NAME OF

JOHN & GERTRUDE C. MATHIESON

Surveyed Sept. 27, 1962, by C. R. Baker