


UNITED STATES
DEPARTMENT OF THE INTERIOR
BUREAU OF LAND MANAGEMENT

SECTION

Oregon State Water Filings

TOWNSHIP 24S, RANGE 40E, W. M.

Wildcat Creek Sh. North

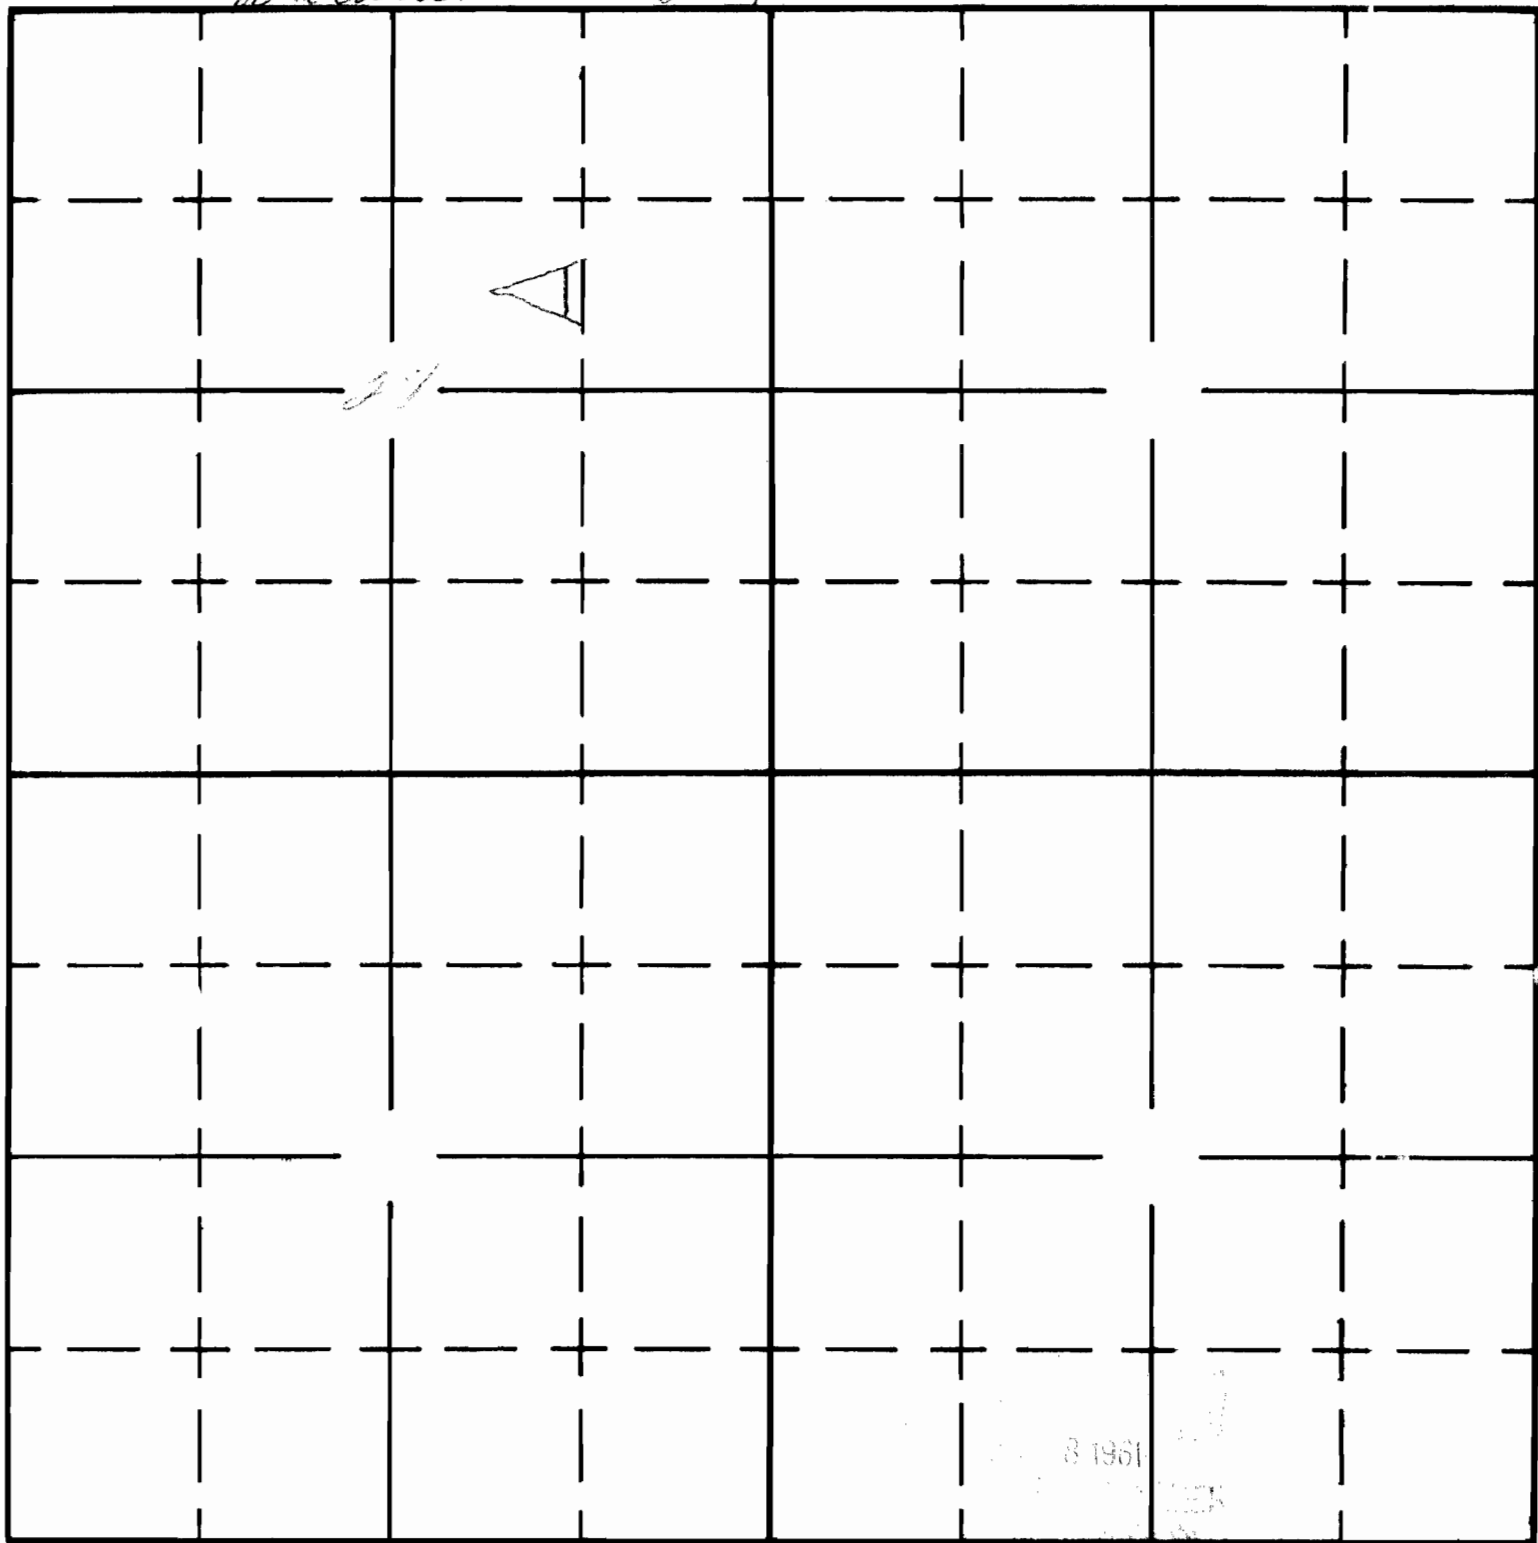

South

APPLICATION No. **R-36763**
PERMIT No. **R-4320**