


SECTION 7

SE 1/4 NE 1/4

TOWNSHIP 41S RANGE 39E W.M.

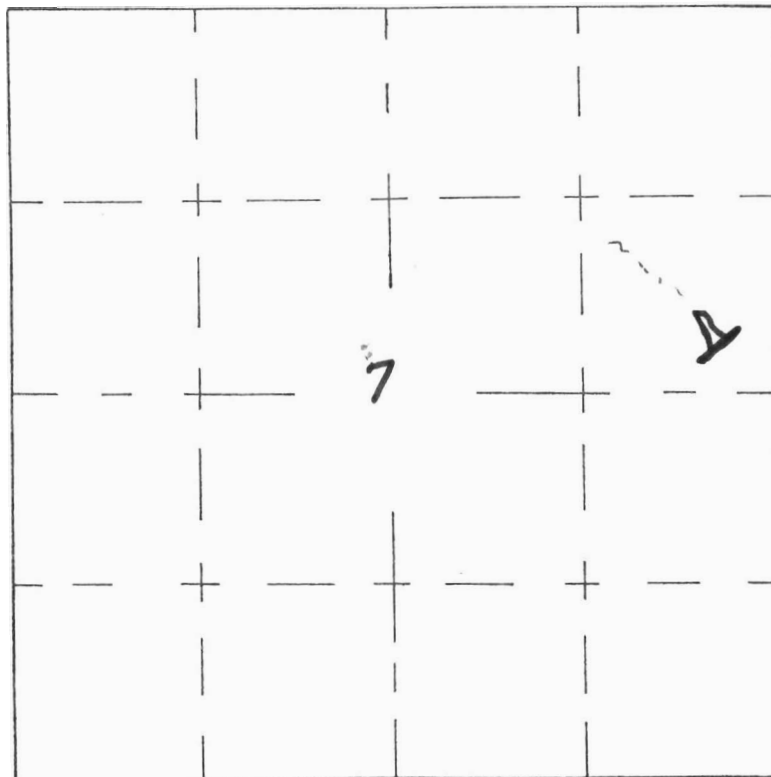

Rough Hole
N^o R59020

Permit No. **R 8673**

REG.
APR 10 1980
WATER RESOURCES D.
SALEM, OREGON