

Form AI-187
March 1961


UNITED STATES
DEPARTMENT OF THE INTERIOR
BUREAU OF LAND MANAGEMENT

SECTION

Oregon State Water Filings

5
SE NW

TOWNSHIP 24S, RANGE 39E, W. M.

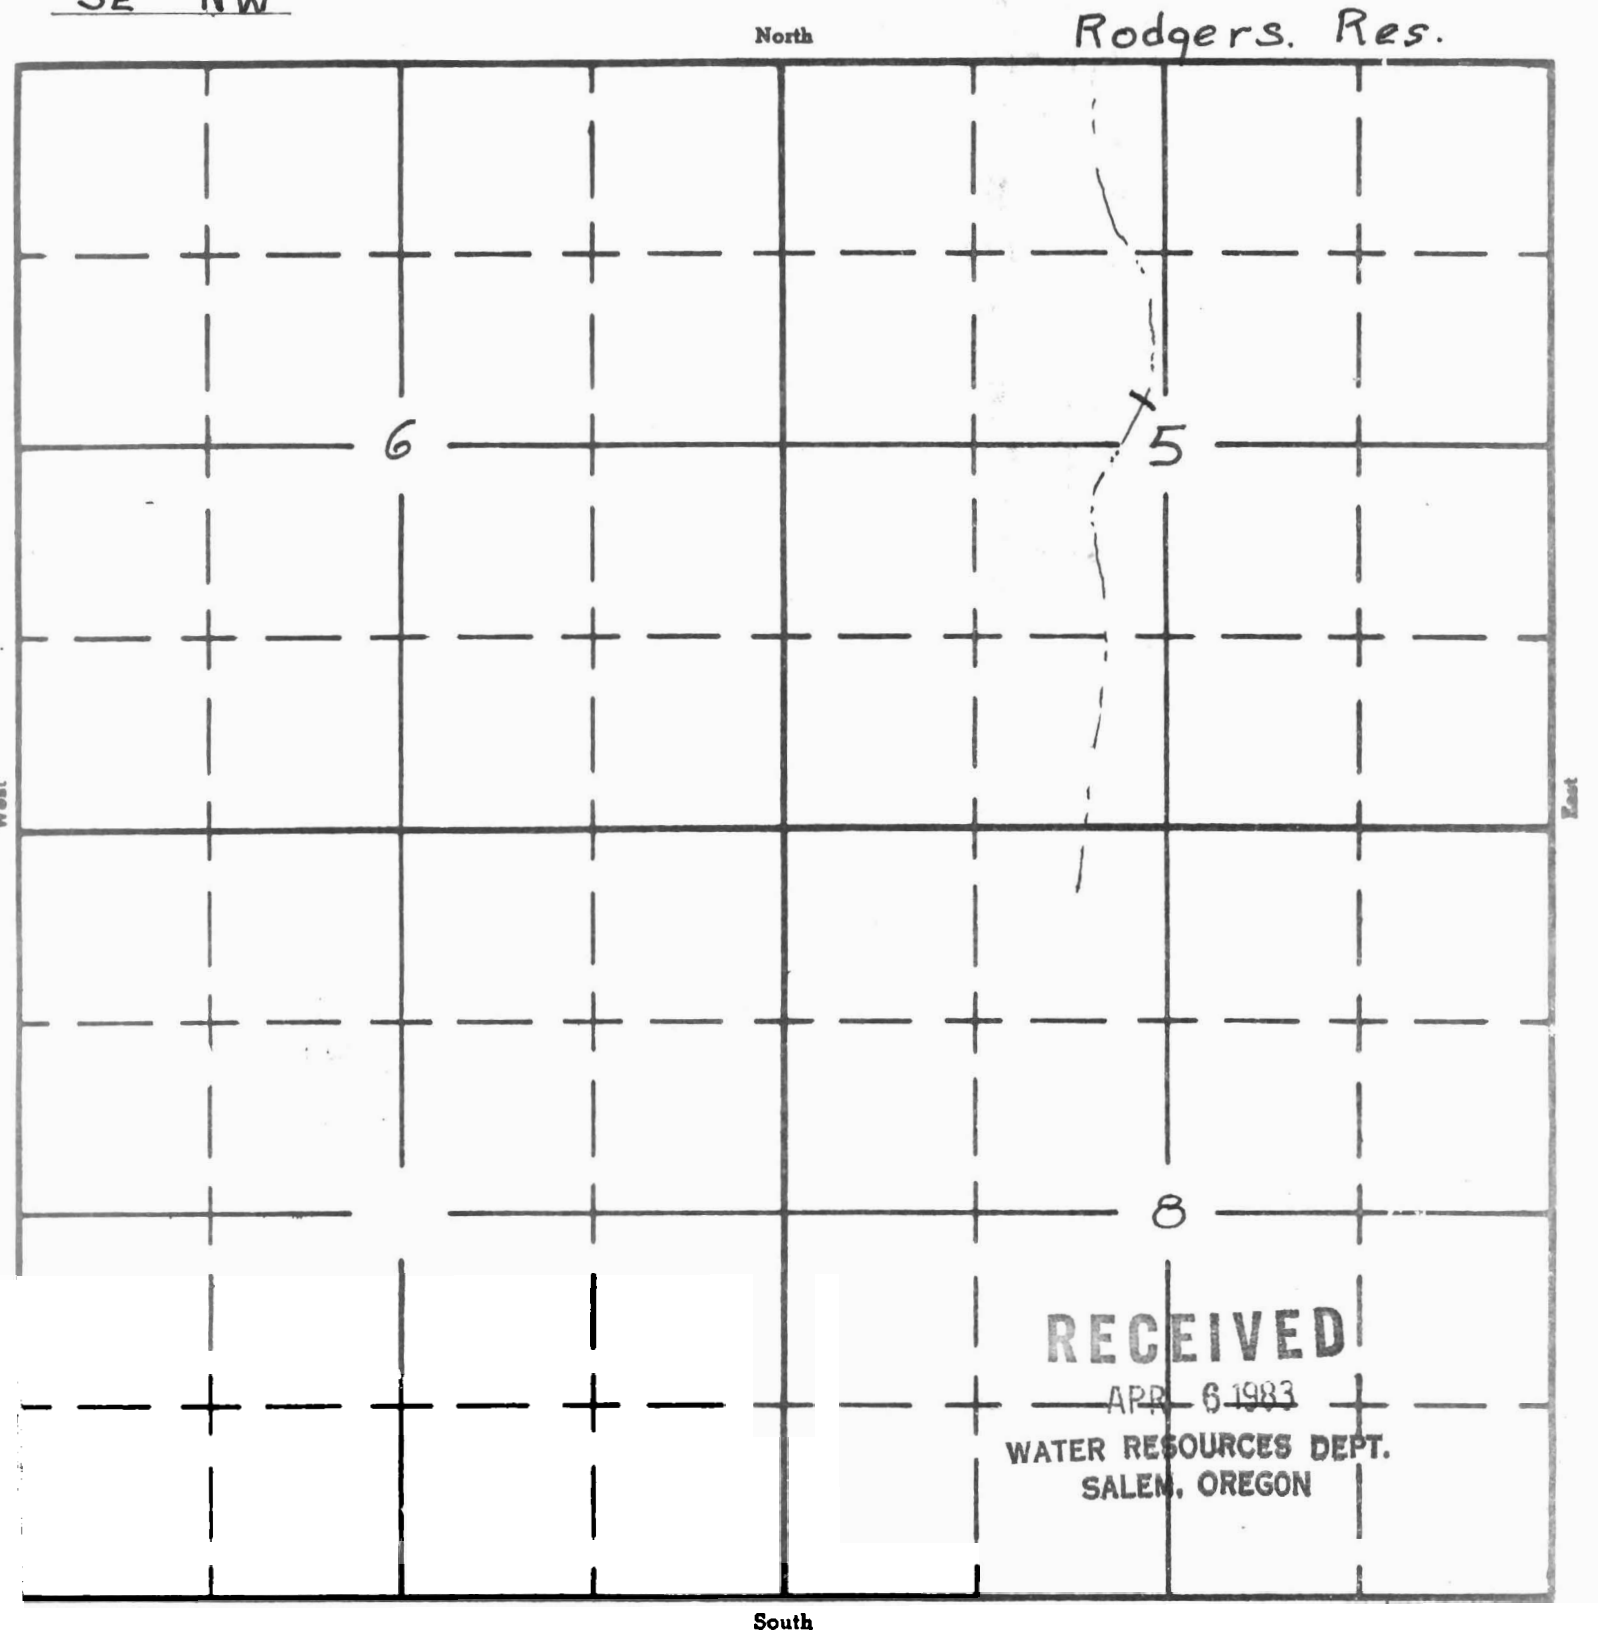

APPLICATION No. R59023
PERMIT No. R 8676