


RECEIVED

AUG - 1979

WATER RESOURCES DEPT

T. 24 S. R. 42 E. W.M.

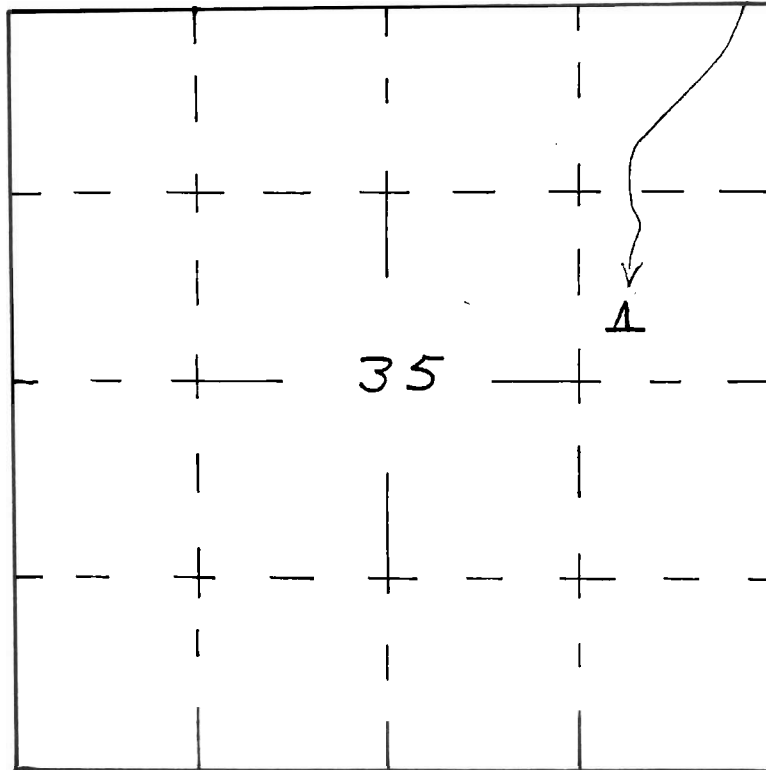

Application No. R59039

Permit No. R 8689

U. S. DEPARTMENT OF THE INTERIOR
BUREAU OF LAND MANAGEMENT

PAGE

DESIGNED _____

RECOMM. _____

DRAWN _____

RECOMM. _____

CHIEF, DIV. OF ENG.

CHECKED _____

APPROVED _____

SCALE _____

DATE _____

SHEET _____ OF _____

DRAWING NO. _____