

UNITED STATES
DEPARTMENT OF THE INTERIOR
BUREAU OF LAND MANAGEMENT

SECTION

NE⁴ NE⁴ Sec. 20


Oregon State Water Filings

RECEIVED

AUG - 1979

TOWNSHIP 24 S., RANGE 42 E., W. M. WATER RESOURCES DEPT
SALEM, OREGON

North

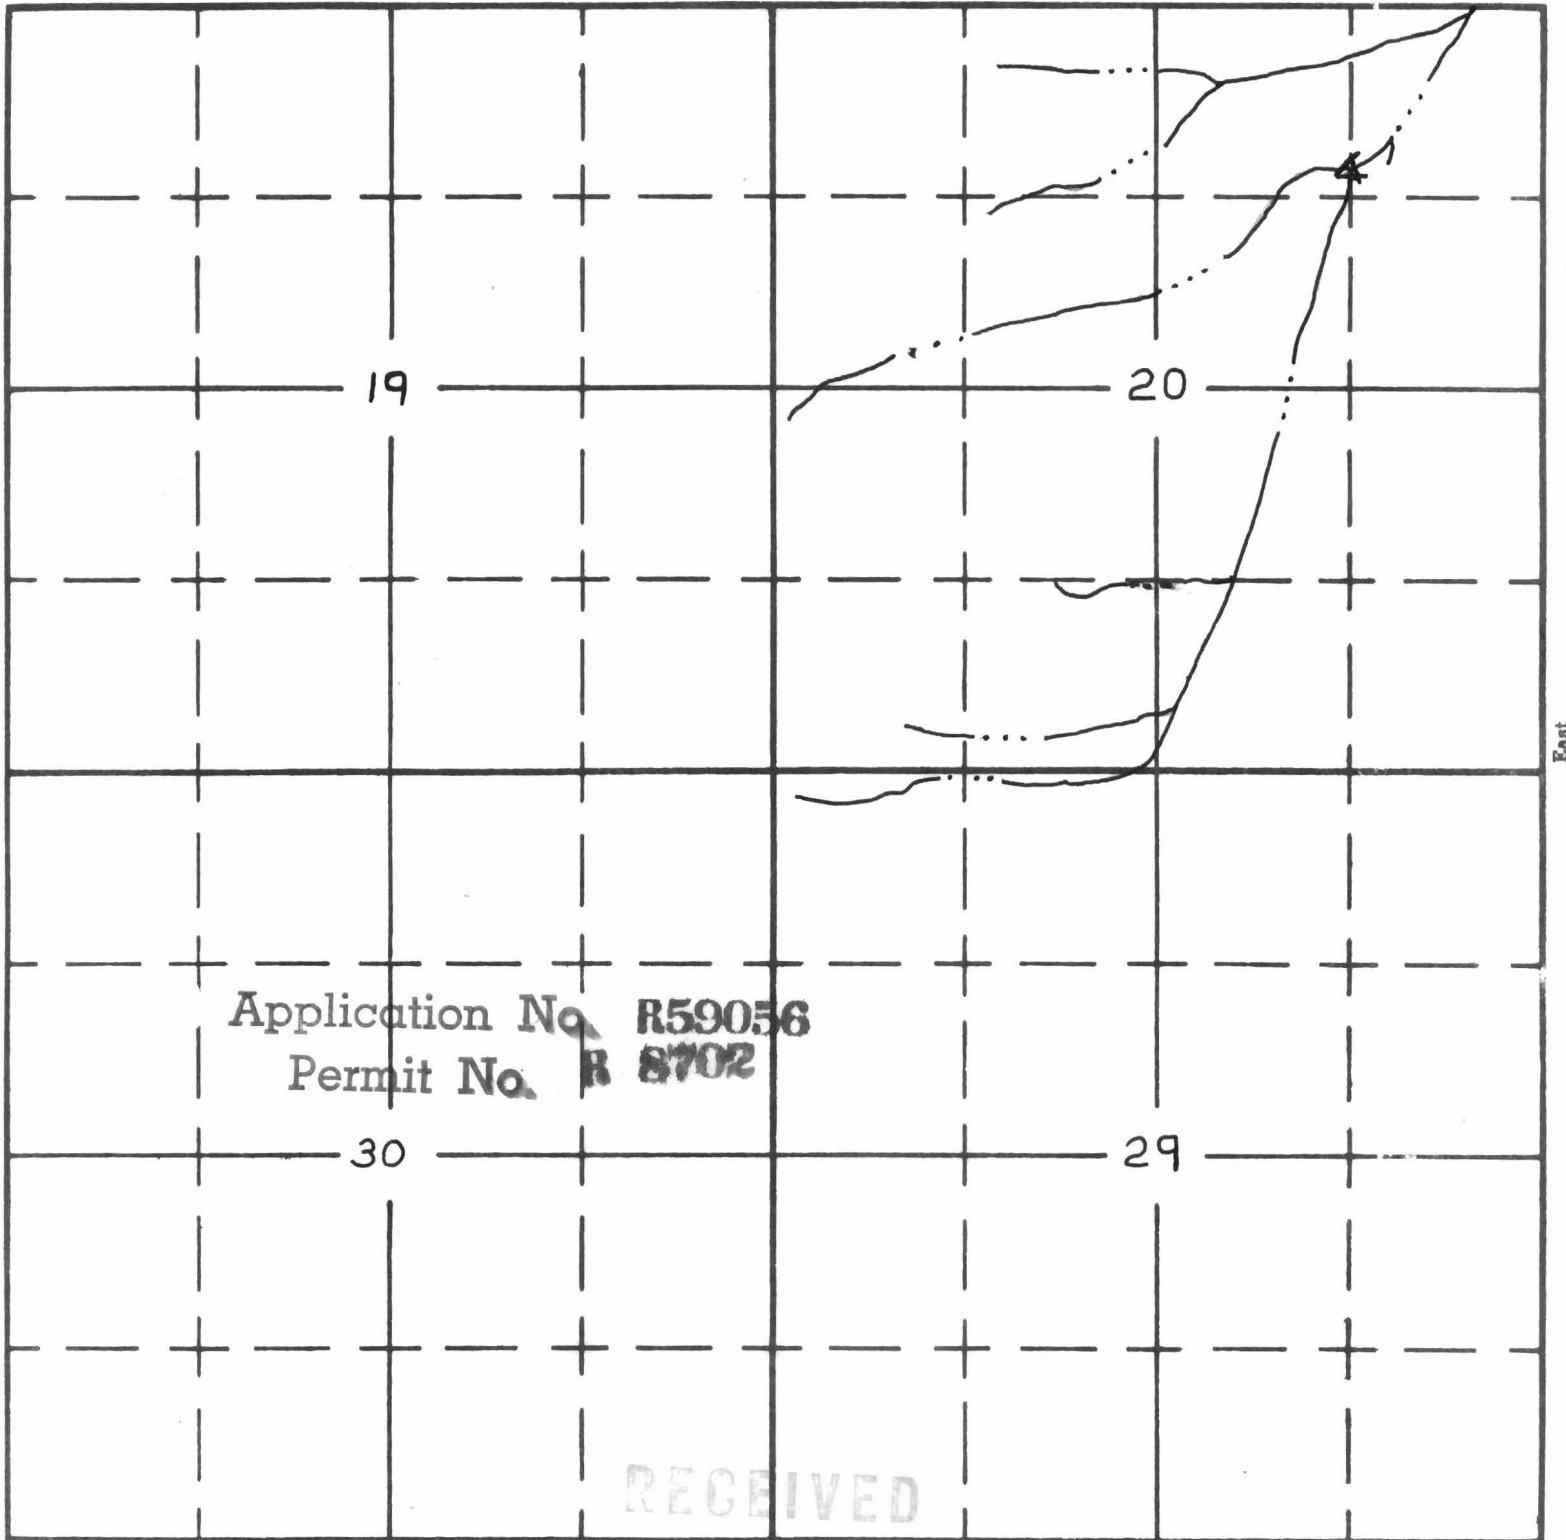

SOMETIMES RES.

South

APPLICATION No.

PERMIT No.