


RECEIVED

AUG - 1979

WATER RESOURCES DEPT
SALEM, OREGON

T. 24 S. R. 40 E. W.M.

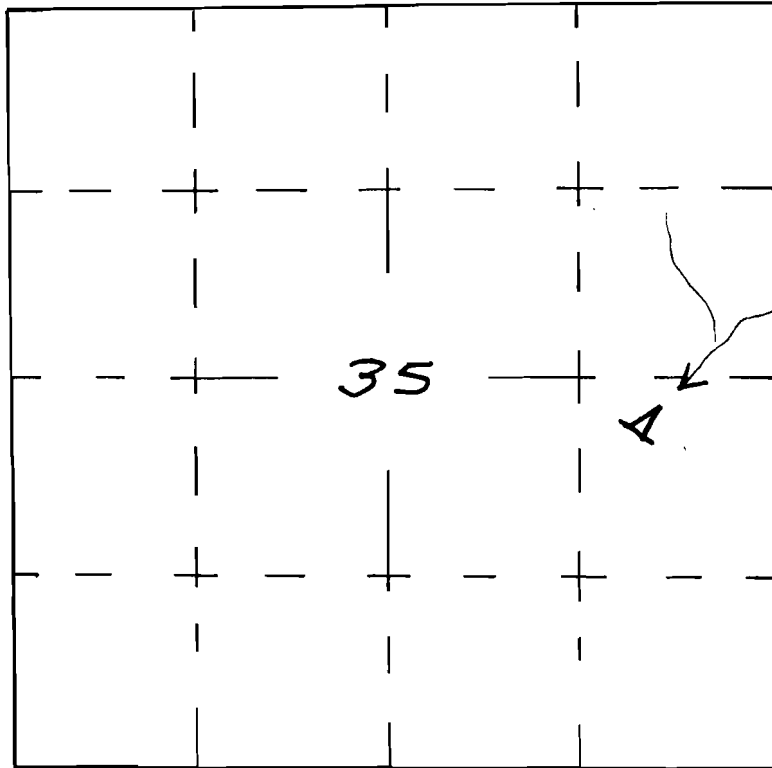

Application No. R59057
Permit No. R 8703

U. S. DEPARTMENT OF THE INTERIOR
BUREAU OF LAND MANAGEMENT

SLEEPY

DESIGNED _____

RECOMM. _____

DRAWN _____

RECOMM. _____

CHIEF, DIV. OF ENG.

CHECKED _____

APPROVED _____

SCALE _____

DATE _____

SHEET _____ OF _____

DRAWING NO. _____

APPLICATION MAP


RESERVOIR LOCATION CHANGE

NW 1/4 SE 1/4 SEC 35 T 24S R 40E W.M.

U.S.G.S. - SKULL SPRINGS, OREG. - 7 1/2'

LEGEND

-  RESERVOIR
-  ROAD
-  CHANNEL
-  FD SEC COR
-  SPRING

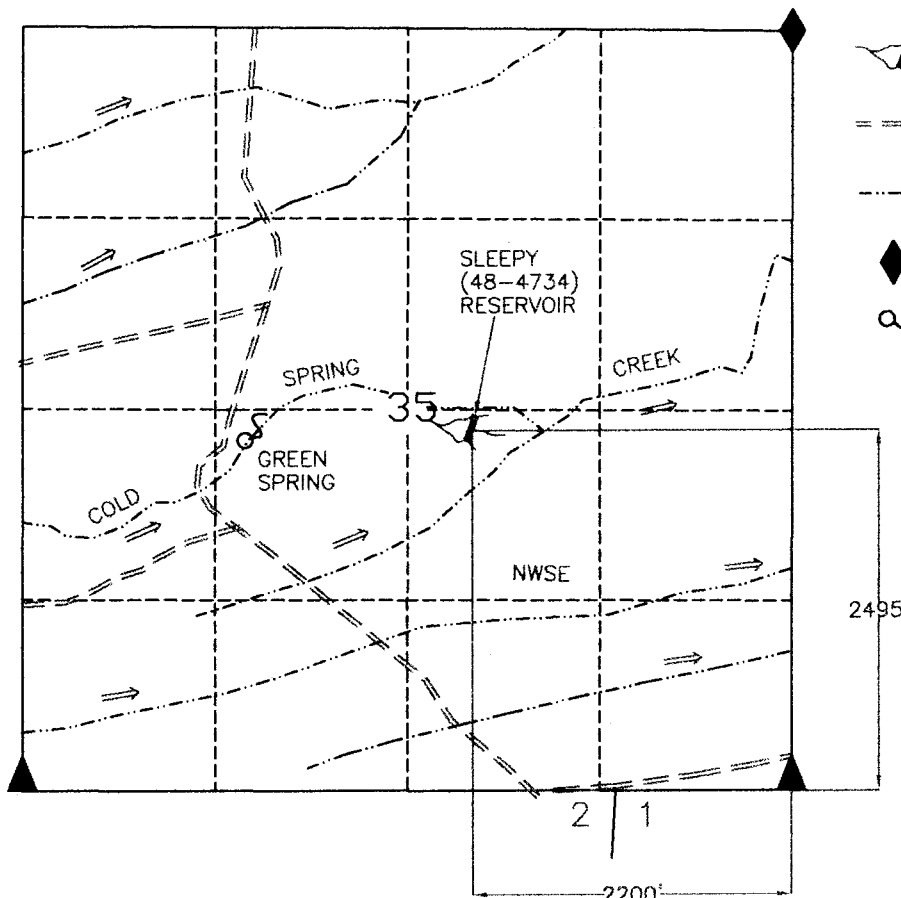


SLEEPY (48-4734) RESERVOIR

RECEIVED

MAR 07 2002

WATER RESOURCES DEPT.
SALEM, OREGON

LAT. 43°26'13.76803"
LONG. 117°46'46.51771"

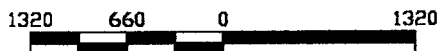

SCALE 1"=1320'

THIS MAP IS FOR THE PURPOSE OF LOCATING
A WATER RIGHT AND IS NOT INTENDED TO
PROVIDE LEGAL DIMENSIONS FOR LOCATION
OF PROPERTY BOUNDARIES.



UNITED STATES DEPARTMENT OF THE INTERIOR
BUREAU OF LAND MANAGEMENT
DIVISION OF OPERATIONS VALE DISTRICT

SLEEPY (48-4734)
RESERVOIR

DESIGNED _____

REVIEWED _____

APPROVED _____

CHIEF, BRANCH OF ENGINEERING

DRAWN: CG

SCALE: 1"=1320'

DATE: 02/11/02

SHEET 1 OF 1

DRAWING NO. DR-03-9172.45-1068

ACAD2000
DWG FILE: SLEEPY4734