


RECEIVED

Aug 11 1979

WATER RESOURCES DIVISION
SHEET NO. 1

T. 24 S. R. 37 E. W.M.

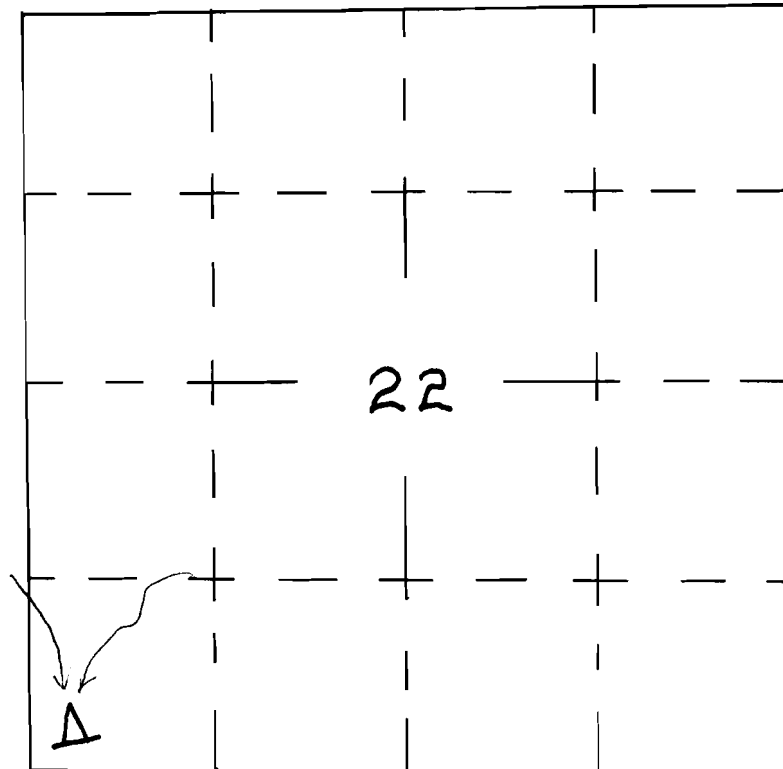

Application No. R59086

Permit No. R 8727

U. S. DEPARTMENT OF THE INTERIOR
BUREAU OF LAND MANAGEMENT

FENCE

DESIGNED _____

RECOMM. _____

DRAWN _____

RECOMM. _____

CHIEF, DIV. OF ENG.

CHECKED _____

APPROVED _____

SCALE _____

DATE _____

SHEET _____ OF _____

DRAWING NO. _____