


SECTION 22

~~SE 1/4 NW 1/4~~

TOWNSHIP 21^S RANGE 38^E W.M.

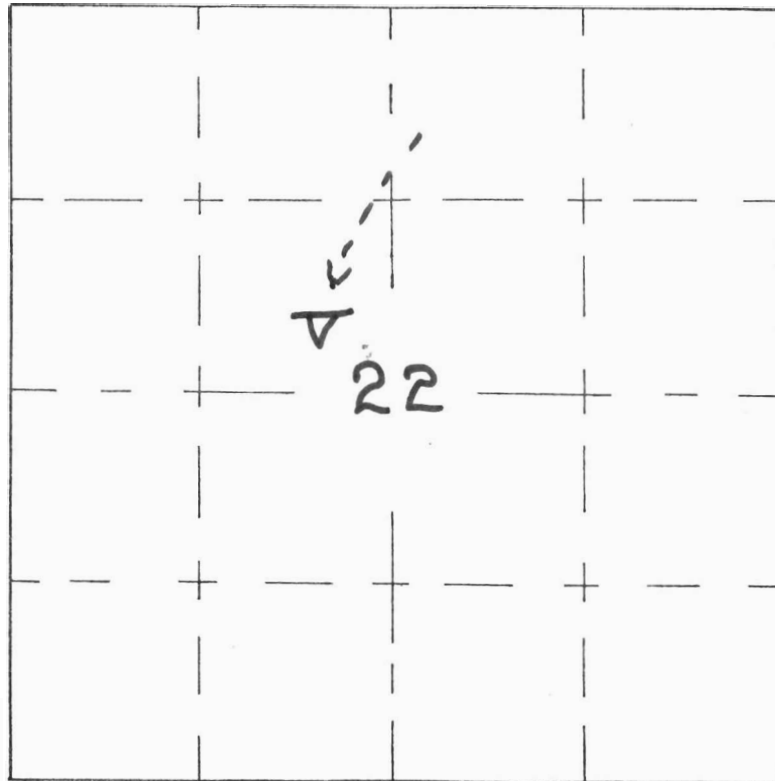

LOWER-DUG-OUT-CR

NO # R 59090

Permit No. R 8730

RECEIVED RECEIVED

APR 6 1983

JAN 14 1983

WATER RESOURCES DEPT. WATER RESOURCES DEPT.
SALEM, OREGON SALEM, OREGON