


SECTION 9

SE 1/4 NE 1/4

TOWNSHIP 31S RANGE 38E W.M.

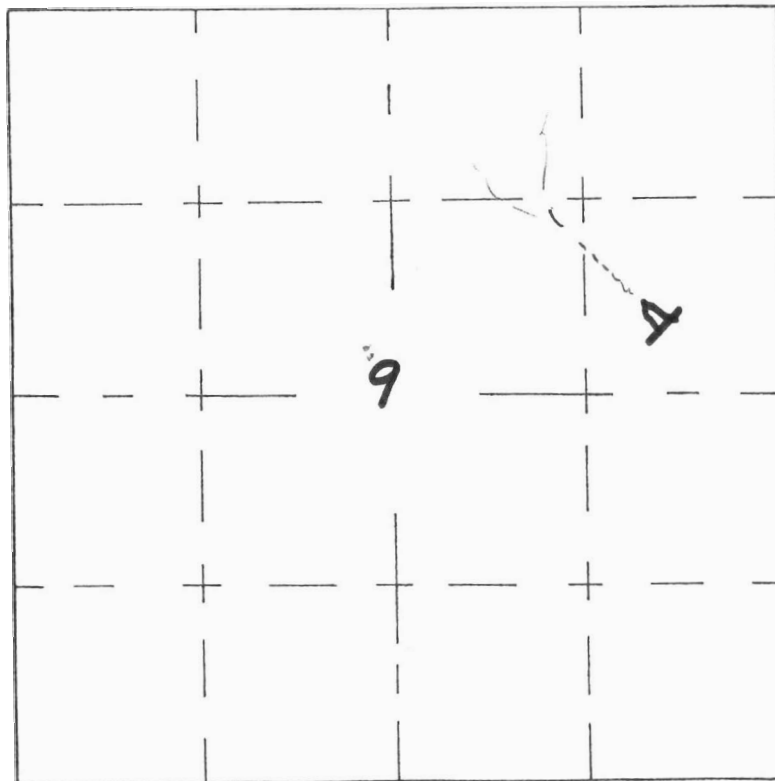

Johnny crk. #2
N^o R 59103

Permit No. R 8741