


WATER RESOURCES DIVISION

T. 27 S. R. 42 E. W.M.

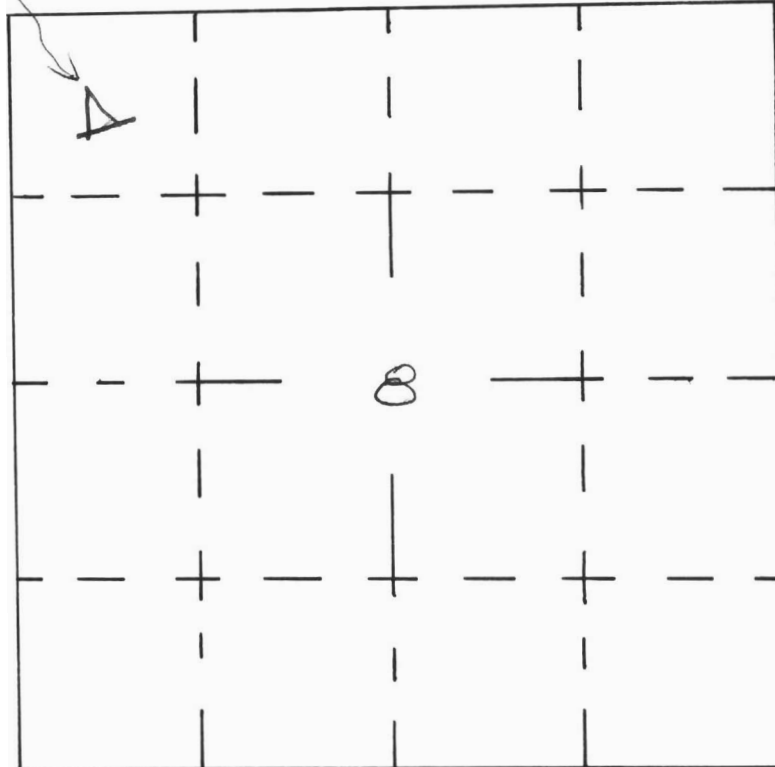

Application No. R59124

Permit No. R 8759

U. S. DEPARTMENT OF THE INTERIOR
BUREAU OF LAND MANAGEMENT

OWYHEE RIM

DESIGNED _____

RECOMM. _____

DRAWN _____

RECOMM. _____

CHIEF, DIV. OF ENG.

CHECKED _____

APPROVED _____

SCALE _____

DATE _____

SHEET _____ OF _____

DRAWING NO. _____