


SECTION 13

NE $\frac{1}{4}$ SE $\frac{1}{4}$

TOWNSHIP 24S RANGE 40E W.M

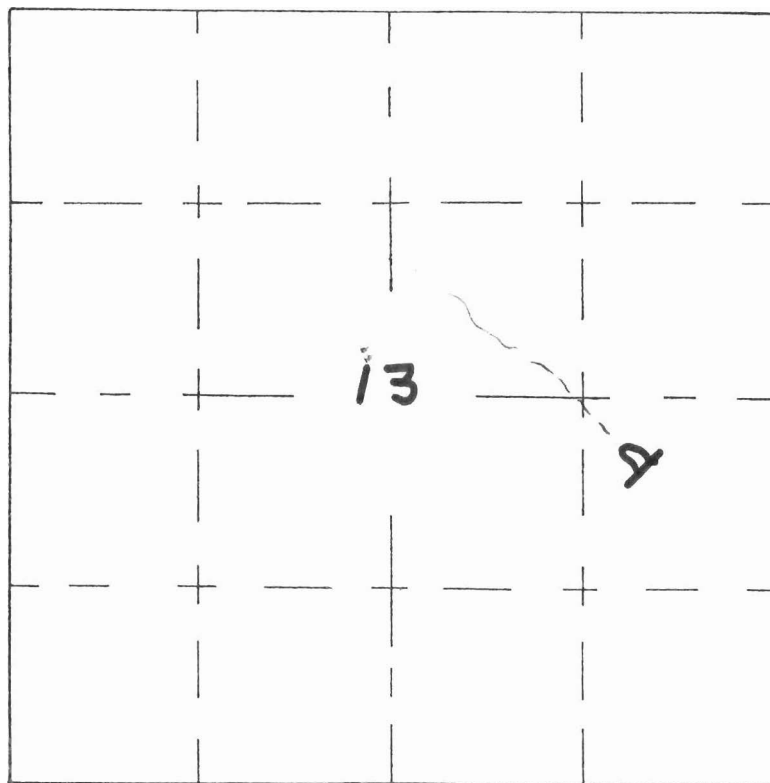

Mountain Dew
No R 59128

Permit No. R 8763