


RECEIVED
APR 1979
WATER RESOURCES DIVISION
U.S. DEPARTMENT OF THE INTERIOR

T. 32 S. R. 38 E. W. M.

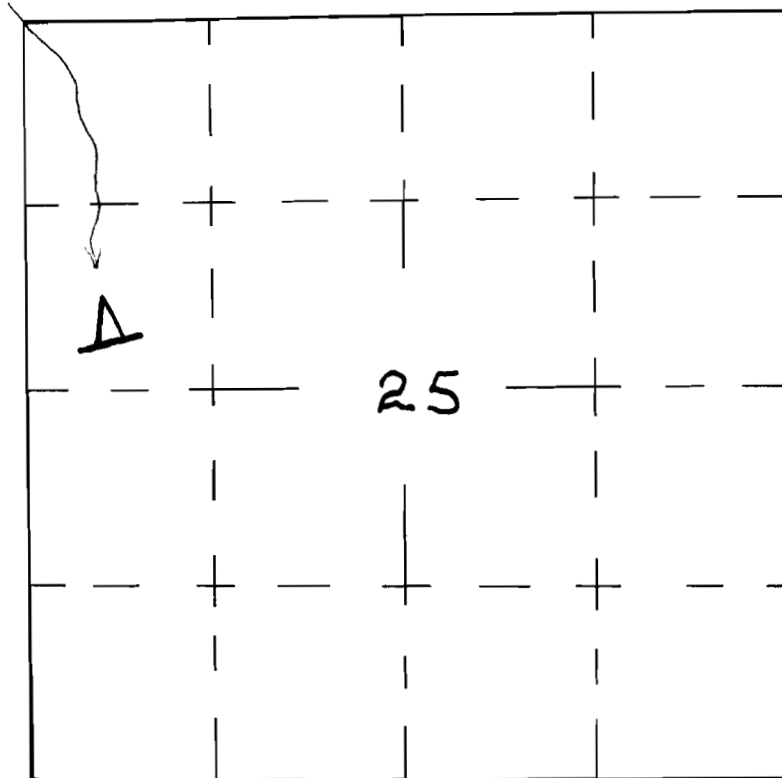

Application No. R59142
Permit No. R 8775

U. S. DEPARTMENT OF THE INTERIOR
BUREAU OF LAND MANAGEMENT

BONE CREEK

DESIGNED _____

RECOMM. _____

DRAWN _____

RECOMM. _____

CHIEF, DIV. OF ENG.

CHECKED _____

APPROVED _____

SCALE _____

DATE _____

SHEET _____ OF _____

DRAWING NO. _____