


WATER

SECTION 10

SE 1/4 NE 1/4

TOWNSHIP 24^S RANGE 39^E W.M.

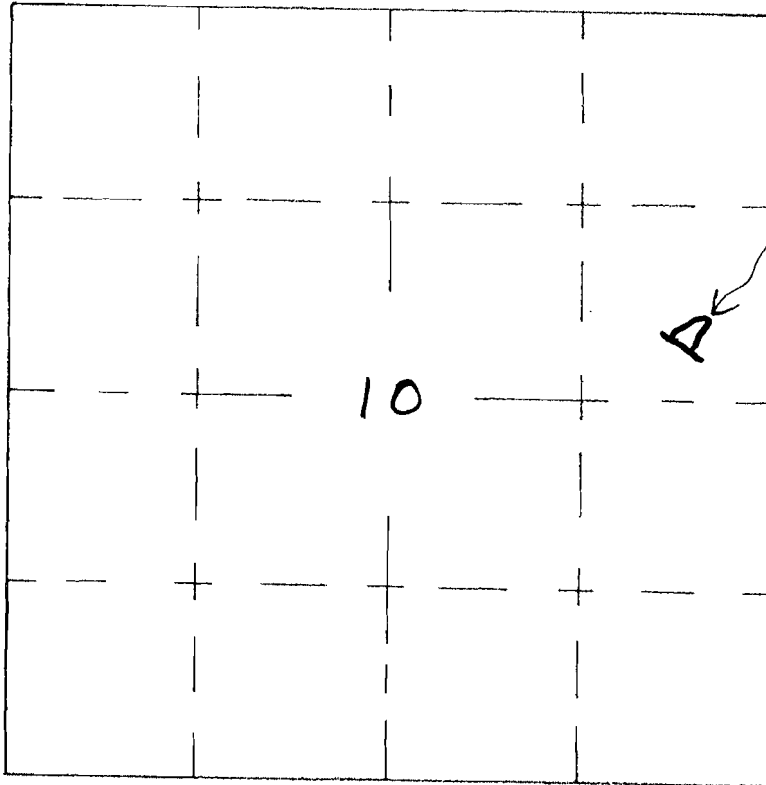

Application No. **R59143**

Permit No. **R 8776**

U. S. DEPARTMENT OF THE INTERIOR
BUREAU OF LAND MANAGEMENT

BRASS CAP

DESIGNED _____

RECOMM. _____

DRAWN _____

RECOMM. _____

CHIEF, DIV. OF ENG.

CHECKED _____

APPROVED _____

SCALE _____

DATE _____

SHEET _____ OF _____

DRAWING NO. _____

RECEIVED


MAR 3 2000

WATER RESOURCES DEPT.
SALEM, OREGON

SECTION 10

SE 1/4 NE 1/4

TOWNSHIP 24^S RANGE 39^E W.M.

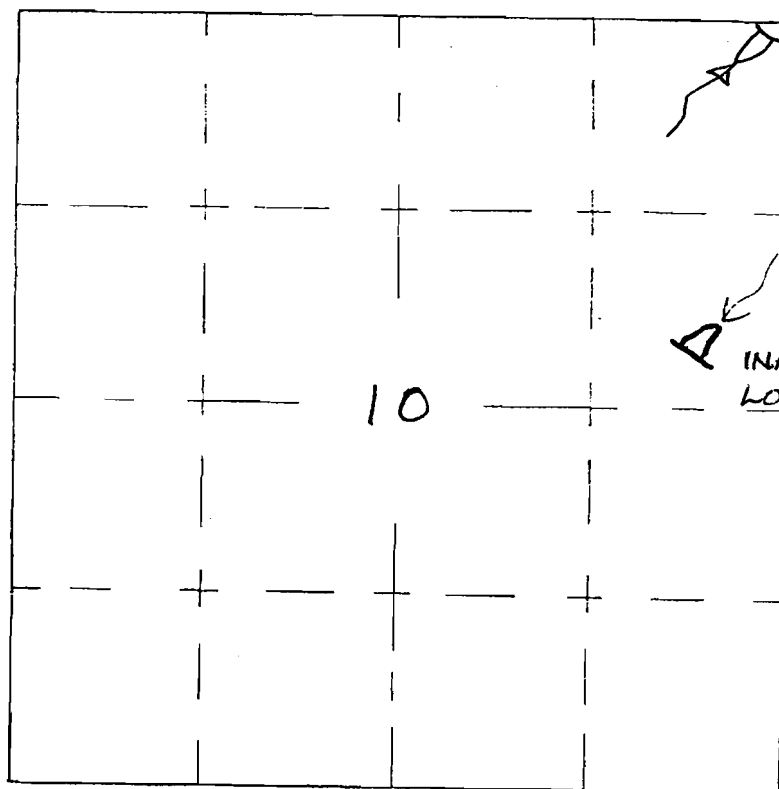

Application No. **R59143**

Permit No. **R 8776**

RECEIVED

APR 01 2002

WATER RESOURCES DEPT.
SALEM, OREGON

U. S. DEPARTMENT OF THE INTERIOR
BUREAU OF LAND MANAGEMENT

BRASS CAP

DESIGNED _____	RECOMM. _____
DRAWN _____	RECOMM. _____
CHECKED _____	APPROVED _____
SCALE _____	
DATE _____	SHEET _____ OF _____
DRAWING NO. _____	