


SECTION 7

NW $\frac{1}{4}$ SE $\frac{1}{4}$

TOWNSHIP 21S RANGE 39E W.M.

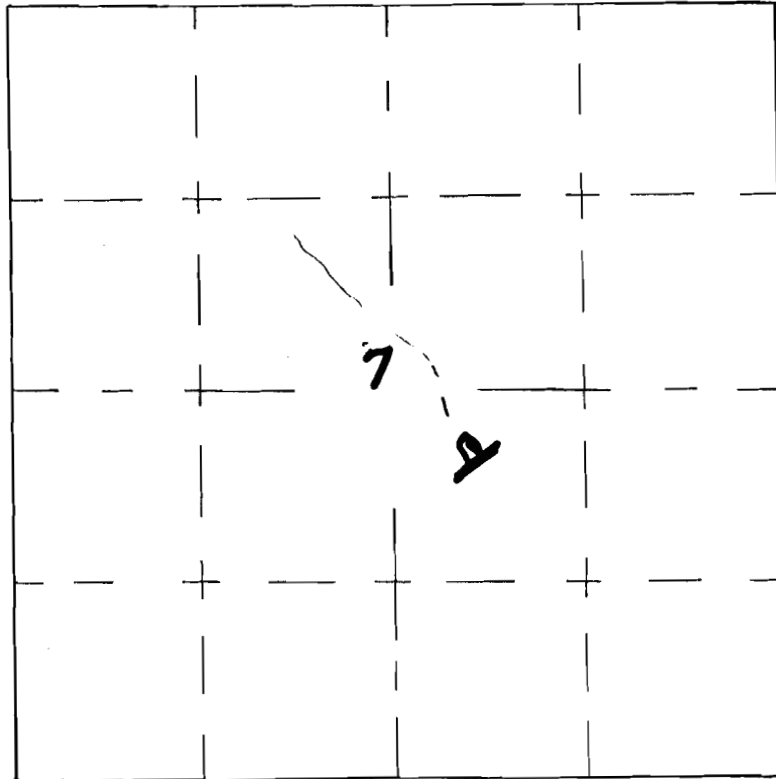


Open "A" Res
Application No. R 59123
Permit No. R 9902

SECTION 7

NW 1/4 SE 1/4

TOWNSHIP 21S RANGE 39E W.M.

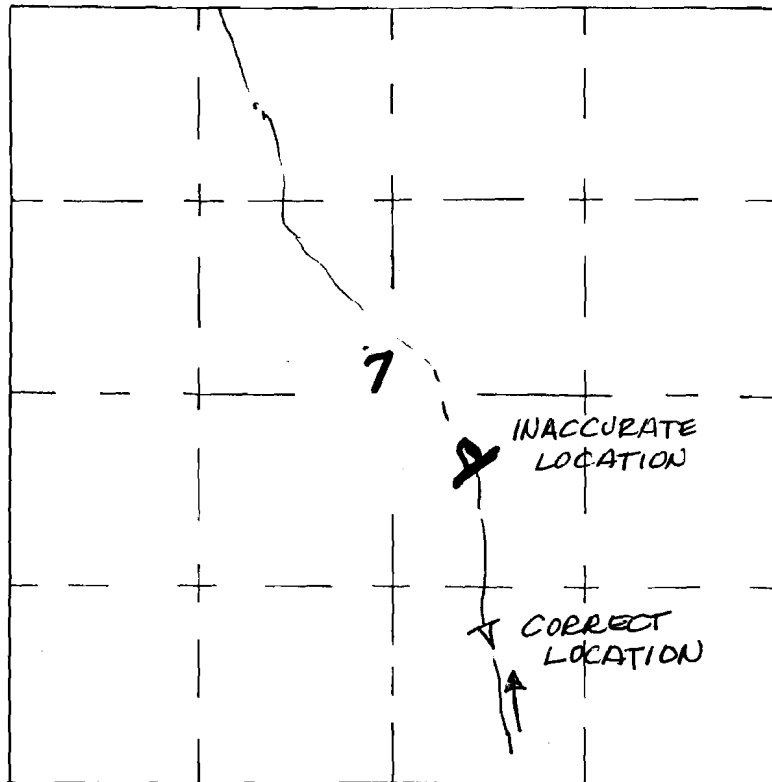

Open "A" Res

Application No. R 59123

Permit No. R 9902

REGISTERED
WATER RESOURCES DEPT.
SALEM, OREGON

RECEIVED


APR 01 2002

WATER RESOURCES DEPT.
SALEM, OREGON

APPLICATION MAP FOR PERMIT TO CONSTRUCT A RESERVOIR

SW1/4SE1/4 SEC 7 T 21S R 39E W.M.


U.S.G.S. QUAD - JONESBORO, OREG. - 7 1/2'

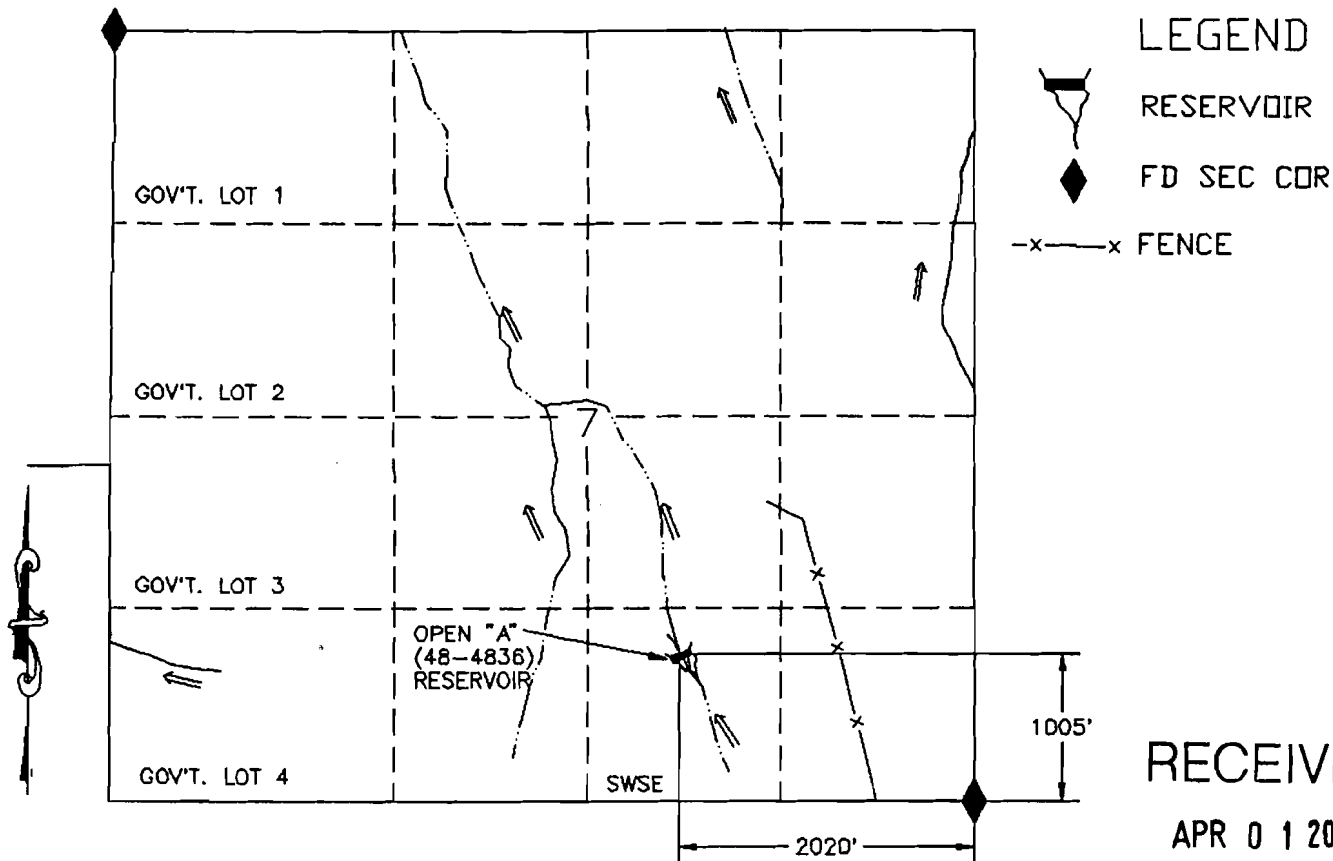

RECEIVED

APR 01 2002

WATER RESOURCES DEPT.
SALEM, OREGON

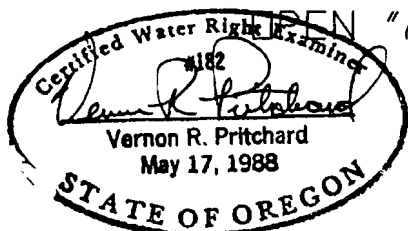

SCALE 1"=1320'

THIS MAP IS FOR THE PURPOSE OF LOCATING
A WATER RIGHT AND IS NOT INTENDED TO
PROVIDE LEGAL DIMENSIONS FOR LOCATION
OF PROPERTY BOUNDARIES.



UNITED STATES DEPARTMENT OF THE INTERIOR BUREAU OF LAND MANAGEMENT DIVISION OF OPERATIONS VALE DISTRICT	
OPEN "A" (48-4836) RESERVOIR	
DESIGNED	
REVIEWED	
APPROVED	
CHIEF, BRANCH OF ENGINEERING	
DRAWN: CG	SCALE: 1"=1320'
DATE: 06/16/93	SHEET 1 OF 1
DRAWING NO. OR-03-9172.45-294	

ACAD RELEASE 11/DCA
DWG FILE: OPENA.DWG