


UNITED STATES
DEPARTMENT OF THE INTERIOR
BUREAU OF LAND MANAGEMENT

SECTION 24
SWSE

Oregon State Water Filings
TOWNSHIP 24S, RANGE 46E, W. M.

North RAW BUTTE RES.

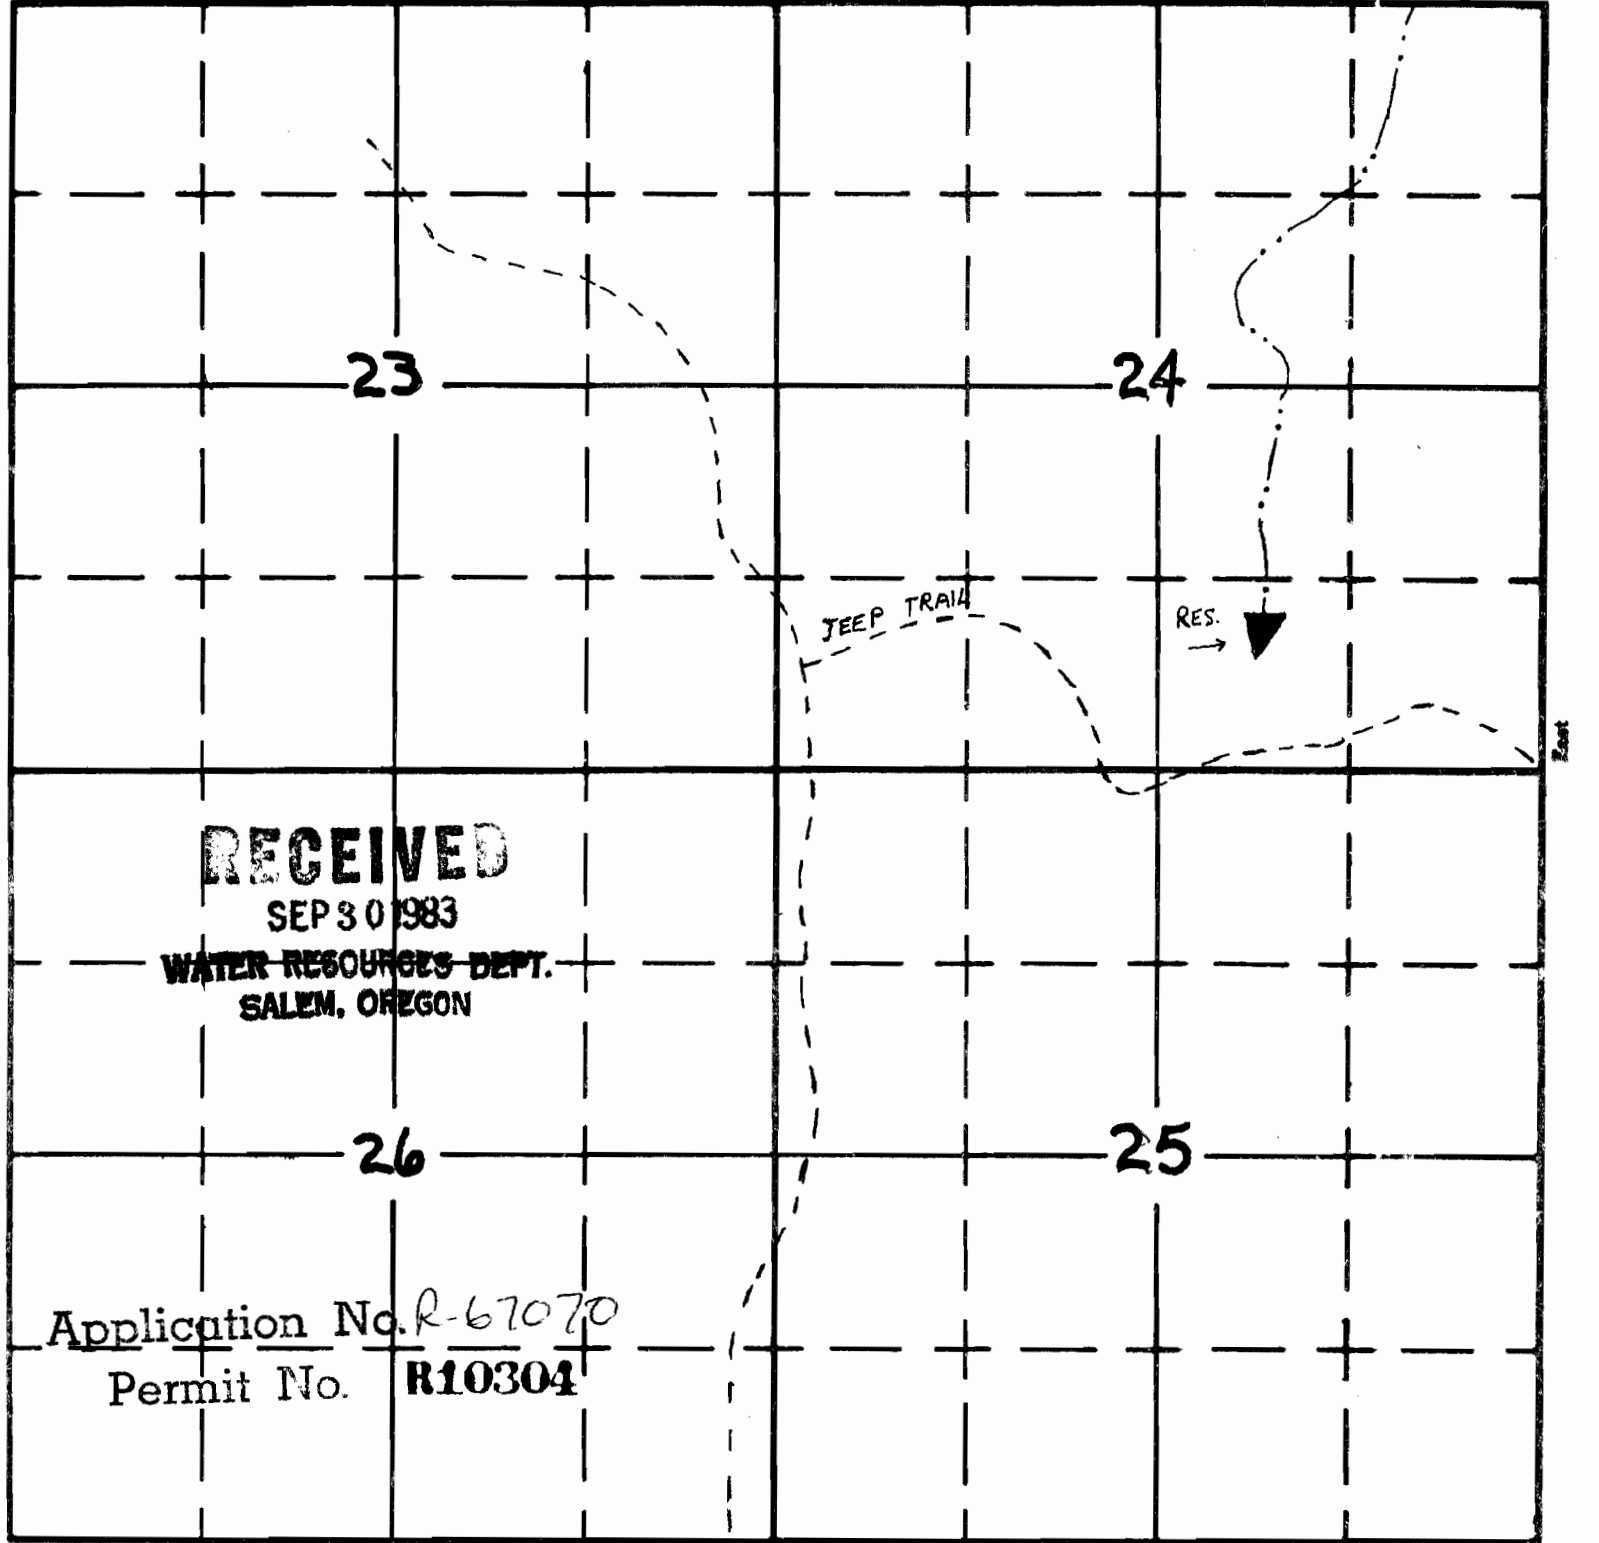

RECEIVED
SEP 30 1983
WATER RESOURCES DEPT.
SALEM, OREGON

Application No. R-67070
Permit No. R10304

South

APPLICATION No.
PERMIT No.