


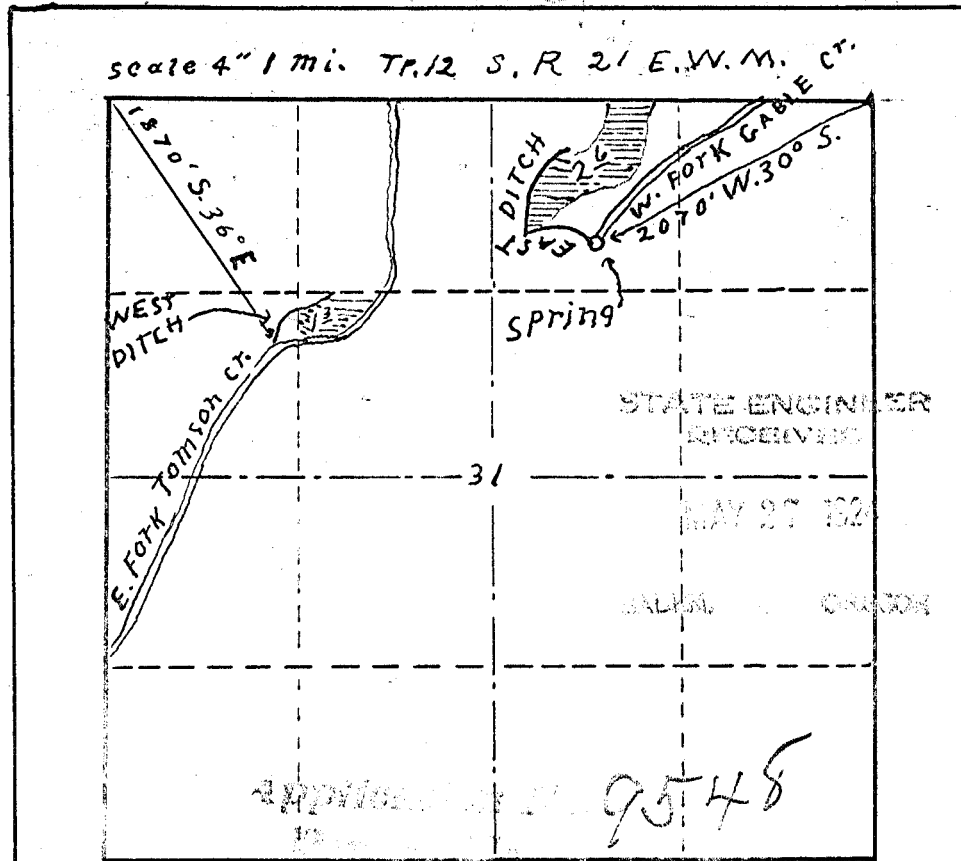

CERTIFICATE OF SURVEYOR
I John M. Vaughan of Mitchell
County of Wheeler State of Oregon
do hereby certify that this map was
made from notes taken during an
actual survey made by me on the 23 day
of May 1924 and it correctly repre-
sents the work described in the accompany-
ing application together with the location
of streams and other ditches in the immediate
vicinity and has written thereon
the area in each smallest legal sub-
division which it is proposed to
irrigate

John M. Vaughan
Surveyor.