

Form A1-187
March 1961

UNITED STATES
DEPARTMENT OF THE INTERIOR
BUREAU OF LAND MANAGEMENT

SECTION


10

Oregon State Water Filings

TOWNSHIP 22S, RANGE 41E, W. M.

SE 1/4 SE 1/4

HIDDEN RESERVOIR

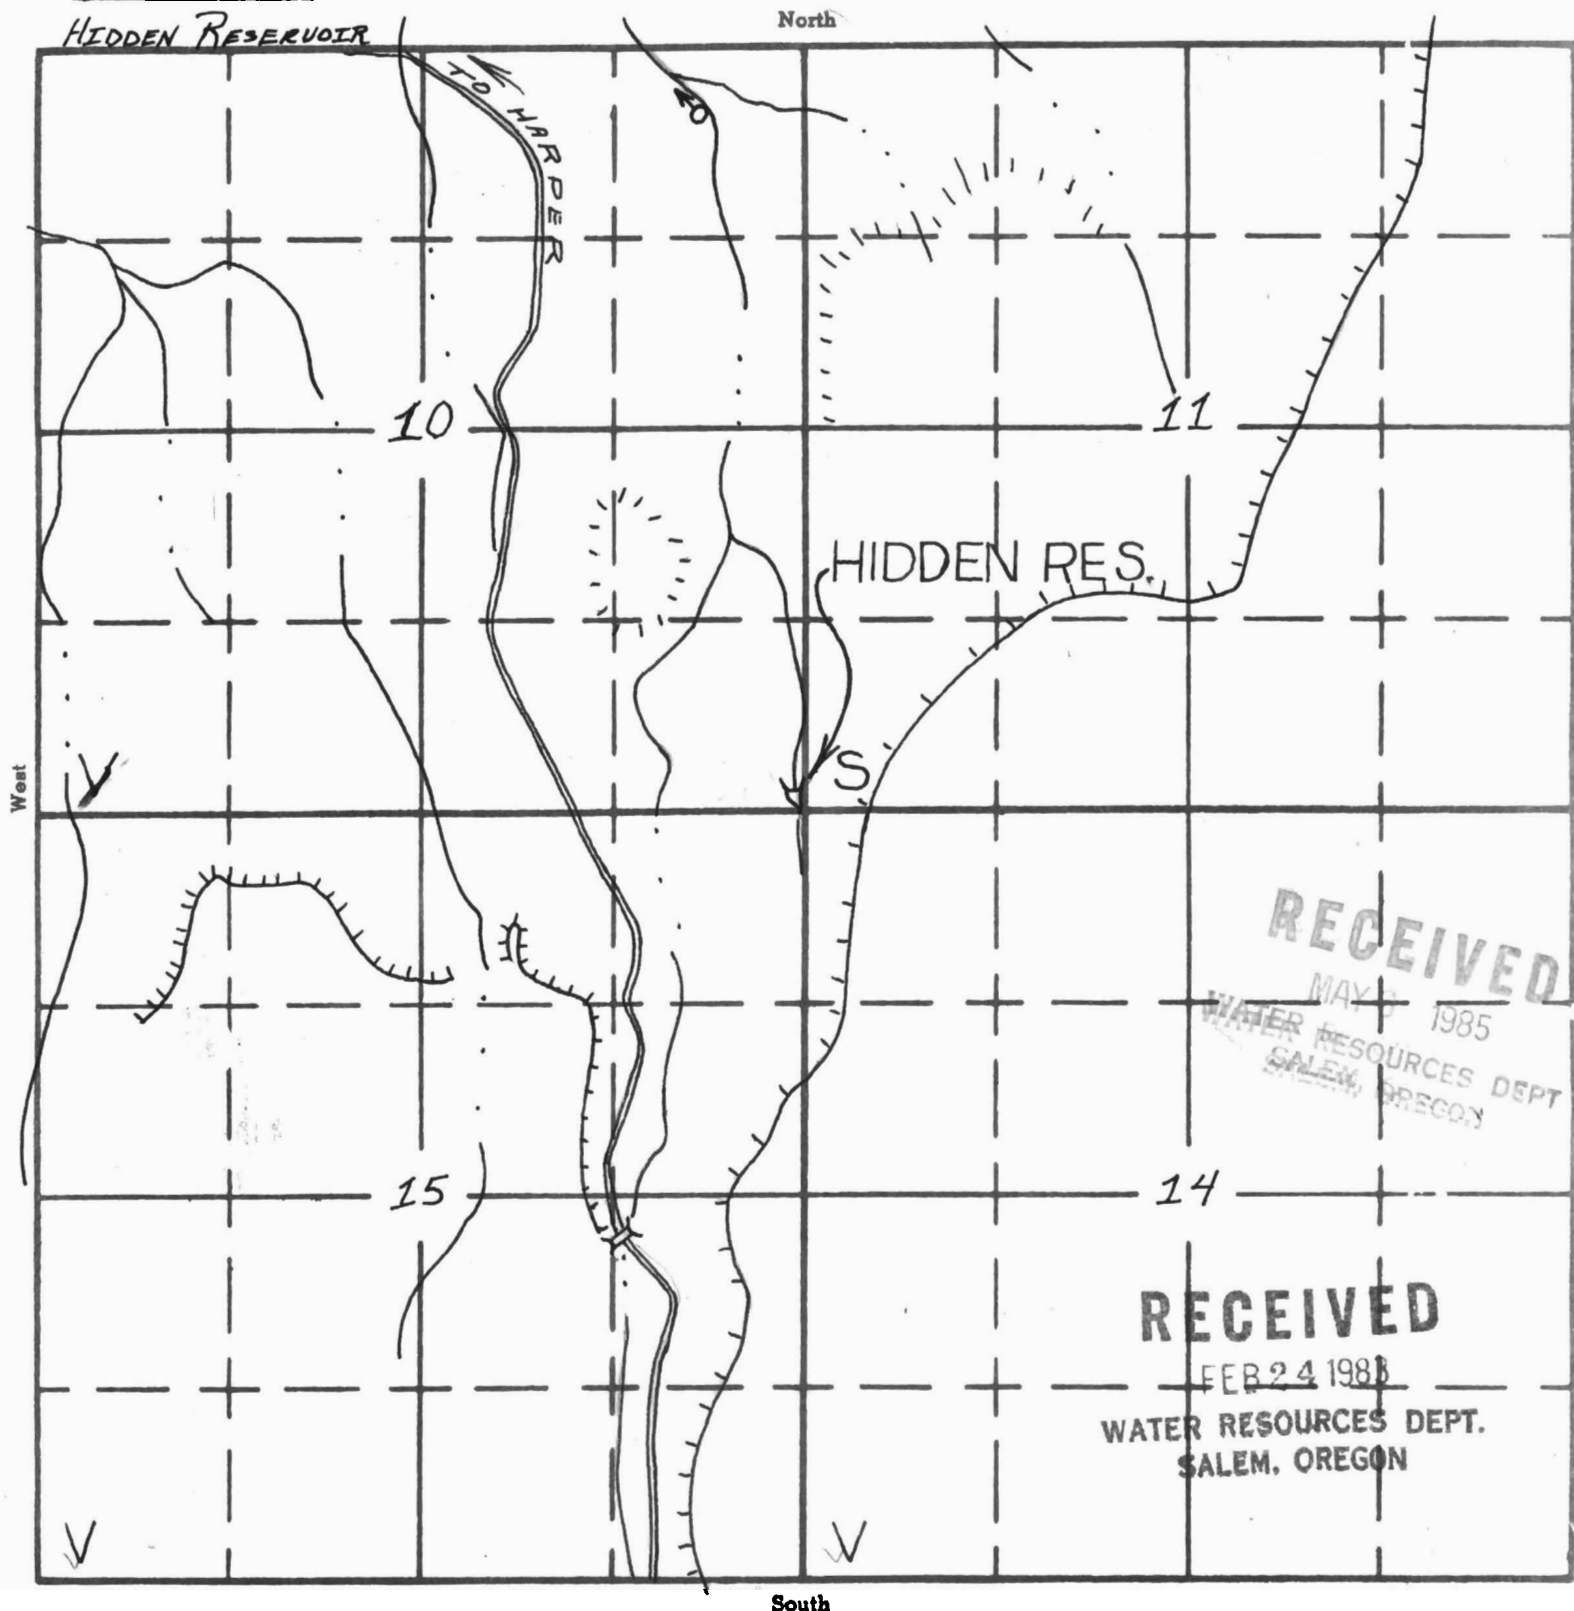

APPLICATION No. P-59100
PERMIT No. R10519