

Form AI-187
March 1961

UNITED STATES
DEPARTMENT OF THE INTERIOR
BUREAU OF LAND MANAGEMENT


SECTION

8 SESW

Oregon State Water Filings

TOWNSHIP 22 S, RANGE 39 E, W. M.

North DINNER CR RES # 1

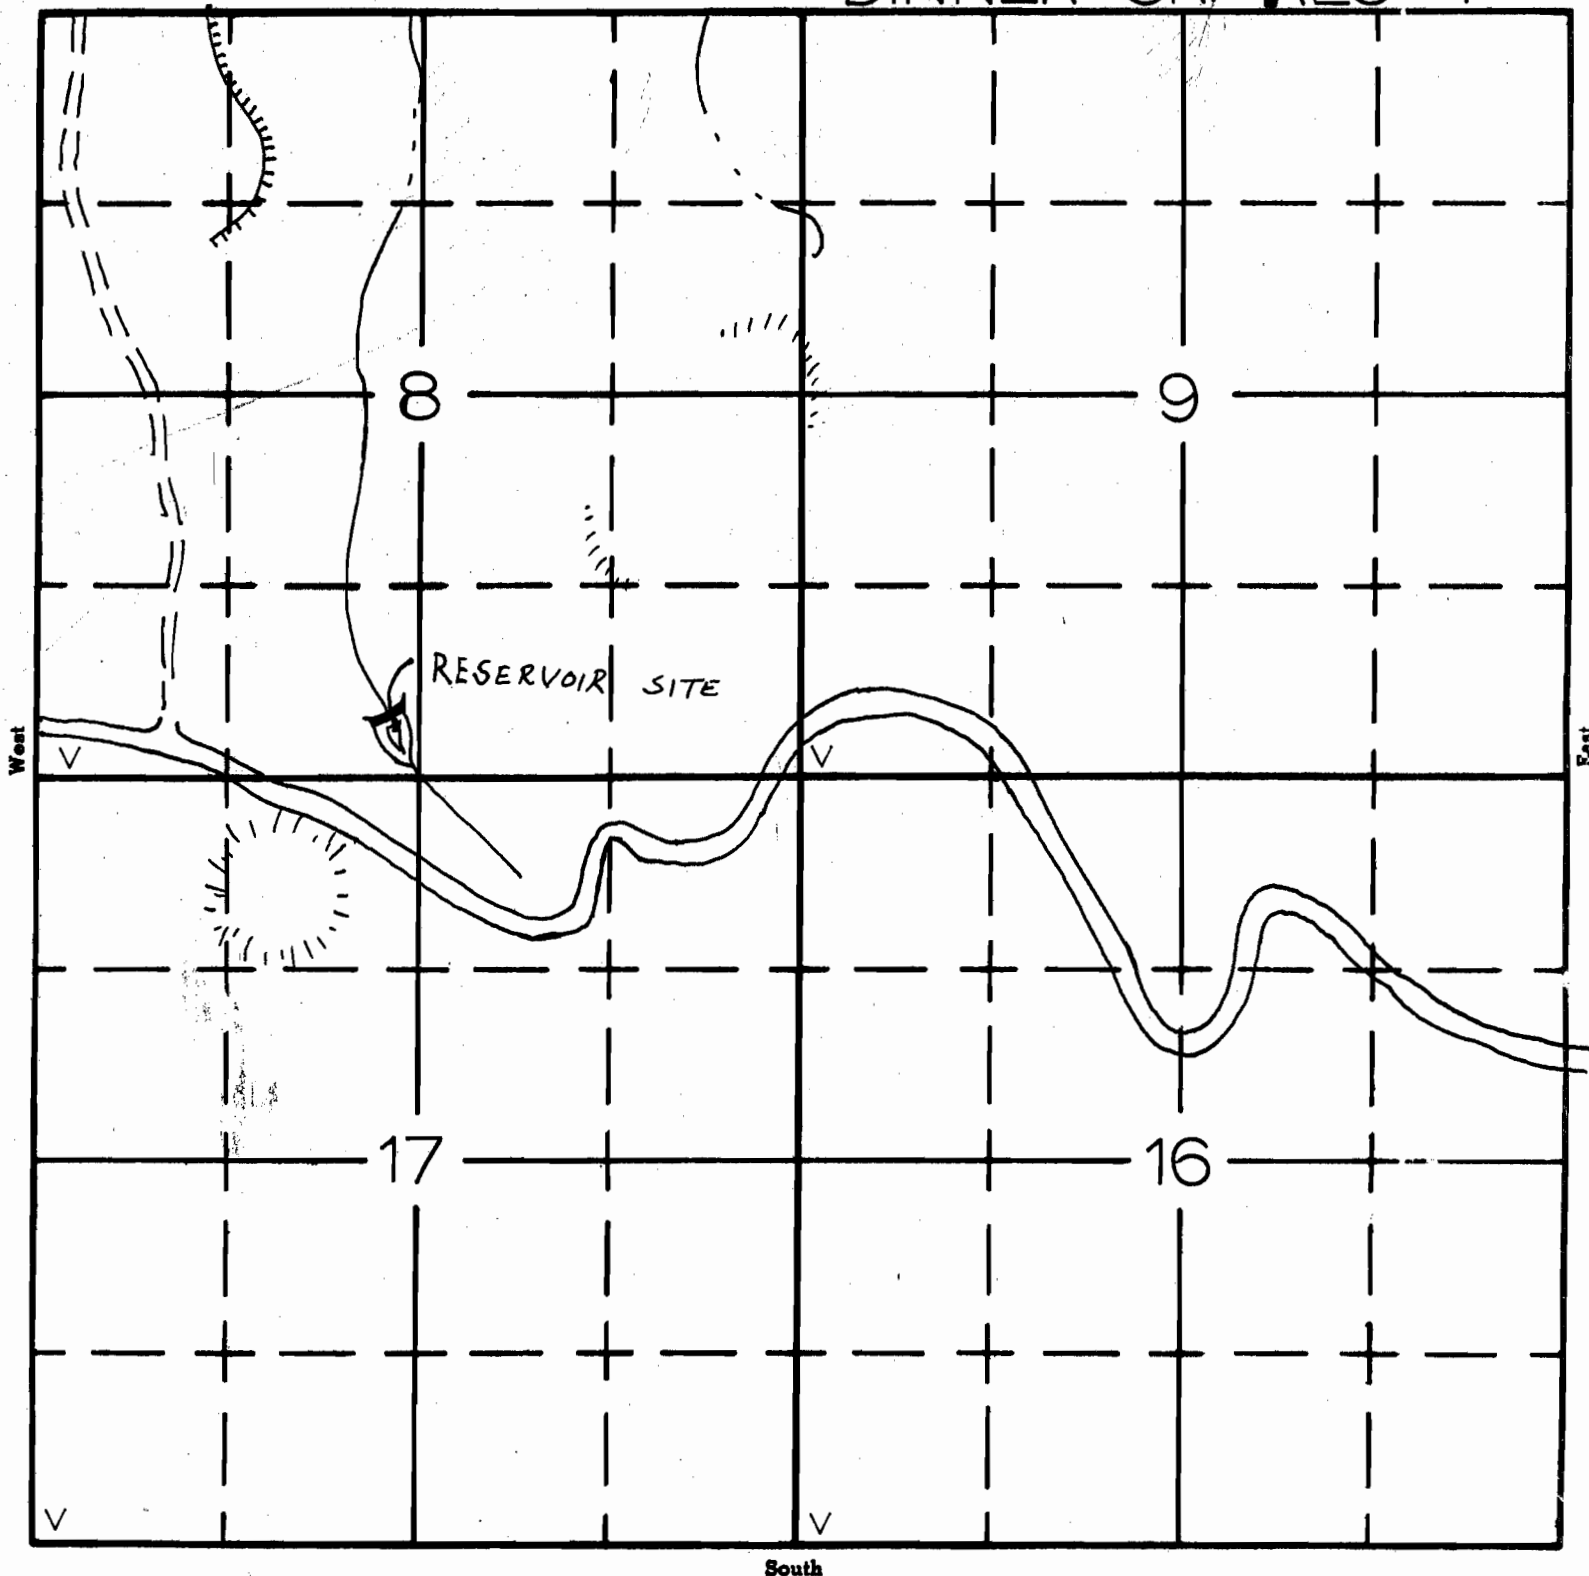

APPLICATION No. R-67819
PERMIT No. R10642