

Form AI-187
March 1961

UNITED STATES
DEPARTMENT OF THE INTERIOR
BUREAU OF LAND MANAGEMENT


SECTION

5 SWSW

Oregon State Water Filings

TOWNSHIP 23 S, RANGE 37 W, W. M.

North RIVERSIDE NO. 2 RES.

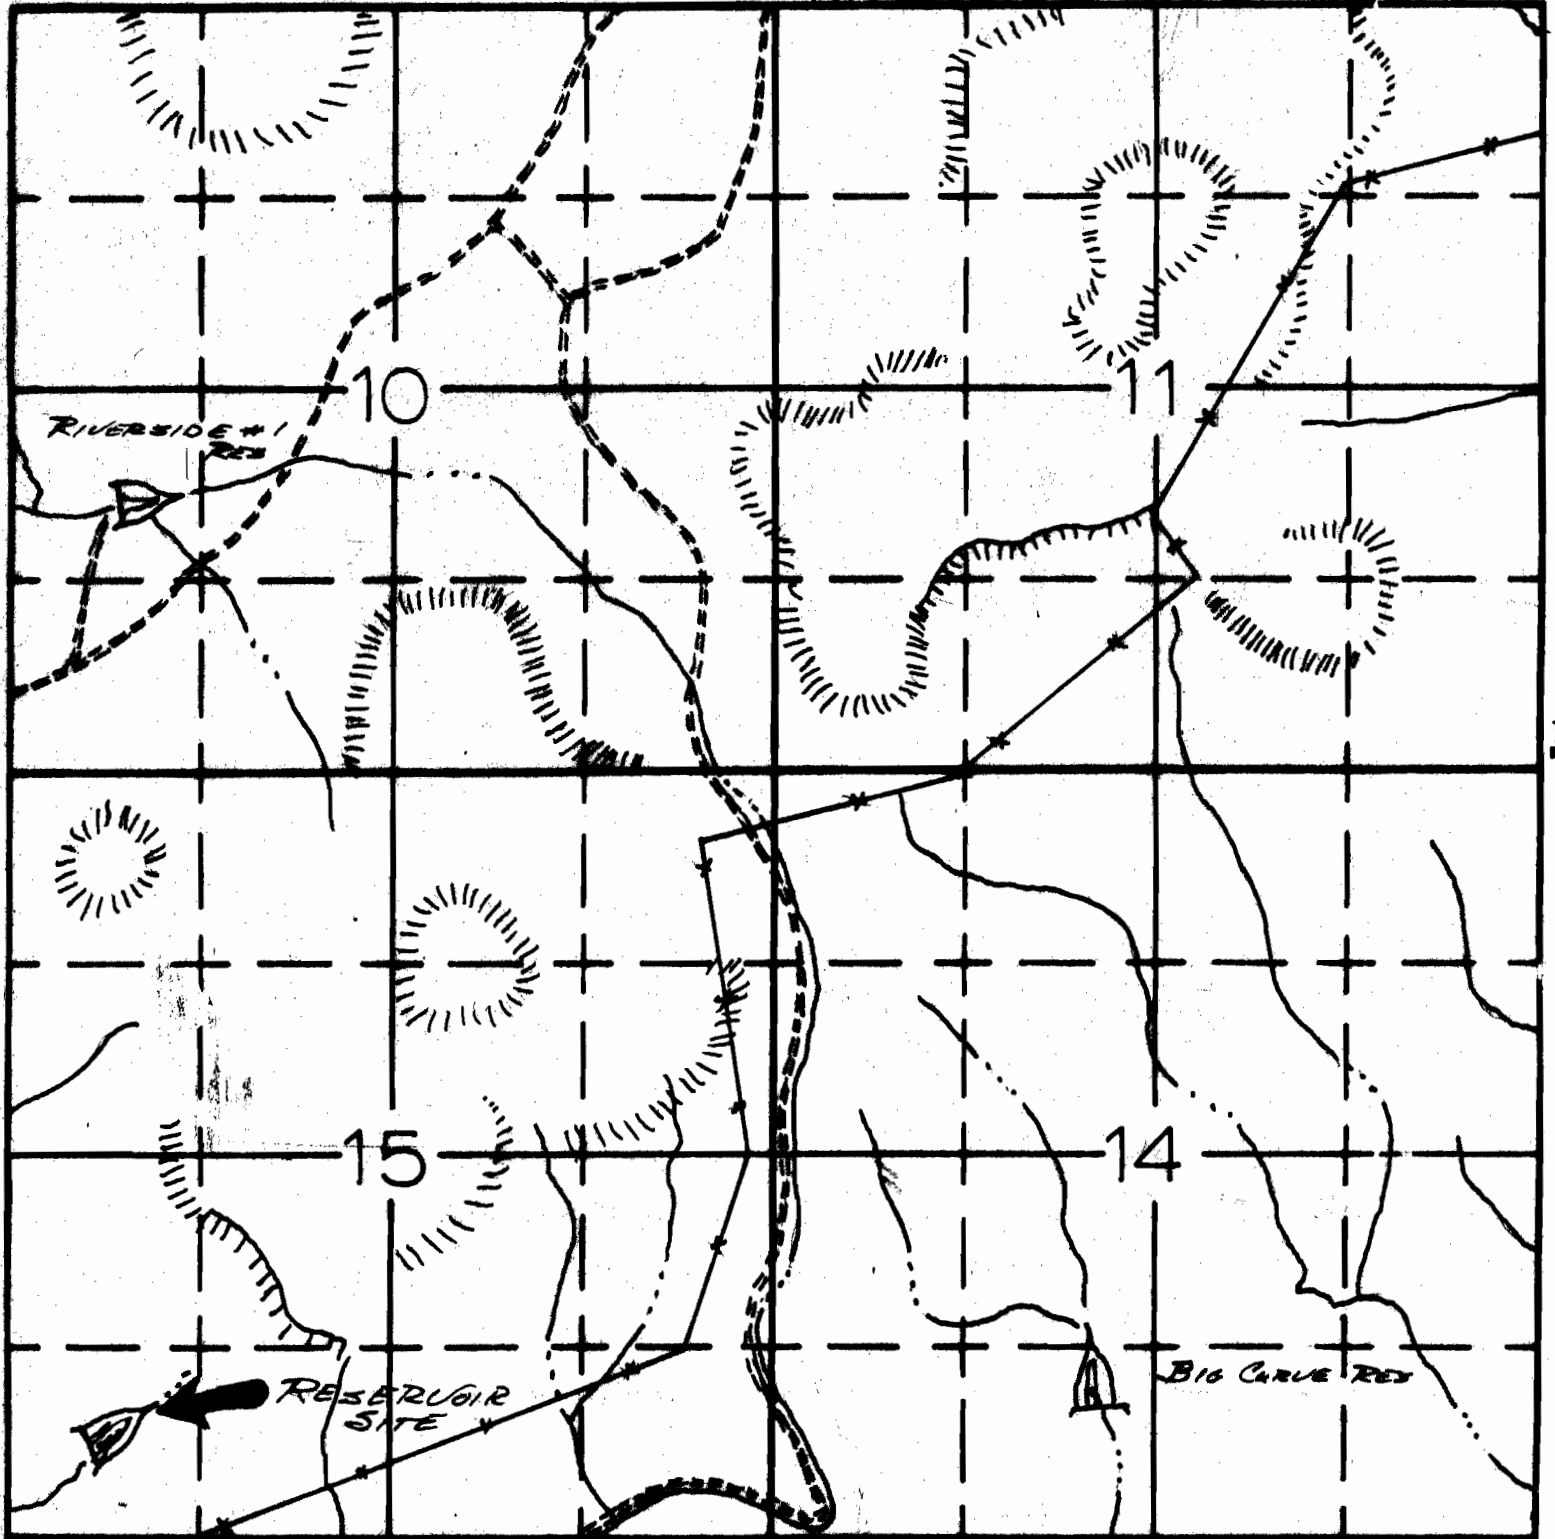

South

R-67879

APPLICATION No. **10657**
PERMIT No.