


T. 39S.R.8W.W.M.

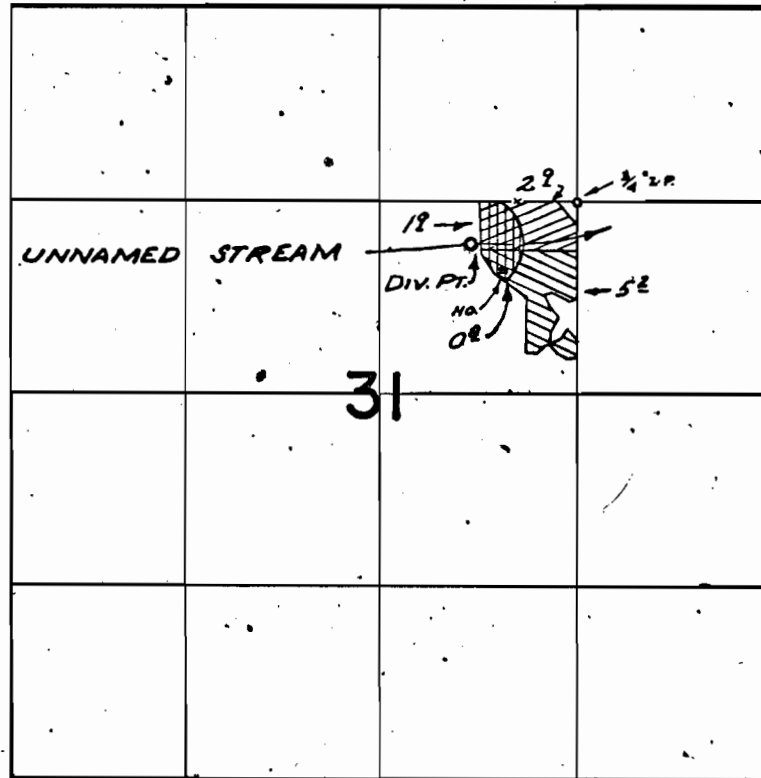

DIV. PT. LOC: 290'S. & 720'W. FROM NE. COR. SW 1/4 NE 1/4 SEC. 31

 → APPL. 41186  → APPL. 42635  → SUPPLEMENTAL

**FINAL PROOF SURVEY**  
UNDER

Application No. <sup>41186</sup>~~42635~~ Permit No. <sup>30805</sup>~~31969~~  
IN NAME OF

AUBREY A. LOGAN

Surveyed JUNE 16 1971, by G. BAGA