

47-247


TOWNSHIP T9S

RANGE R7E

SECTION 20

PROJECT
LOCATION

SCALE
4" = 1 MI.

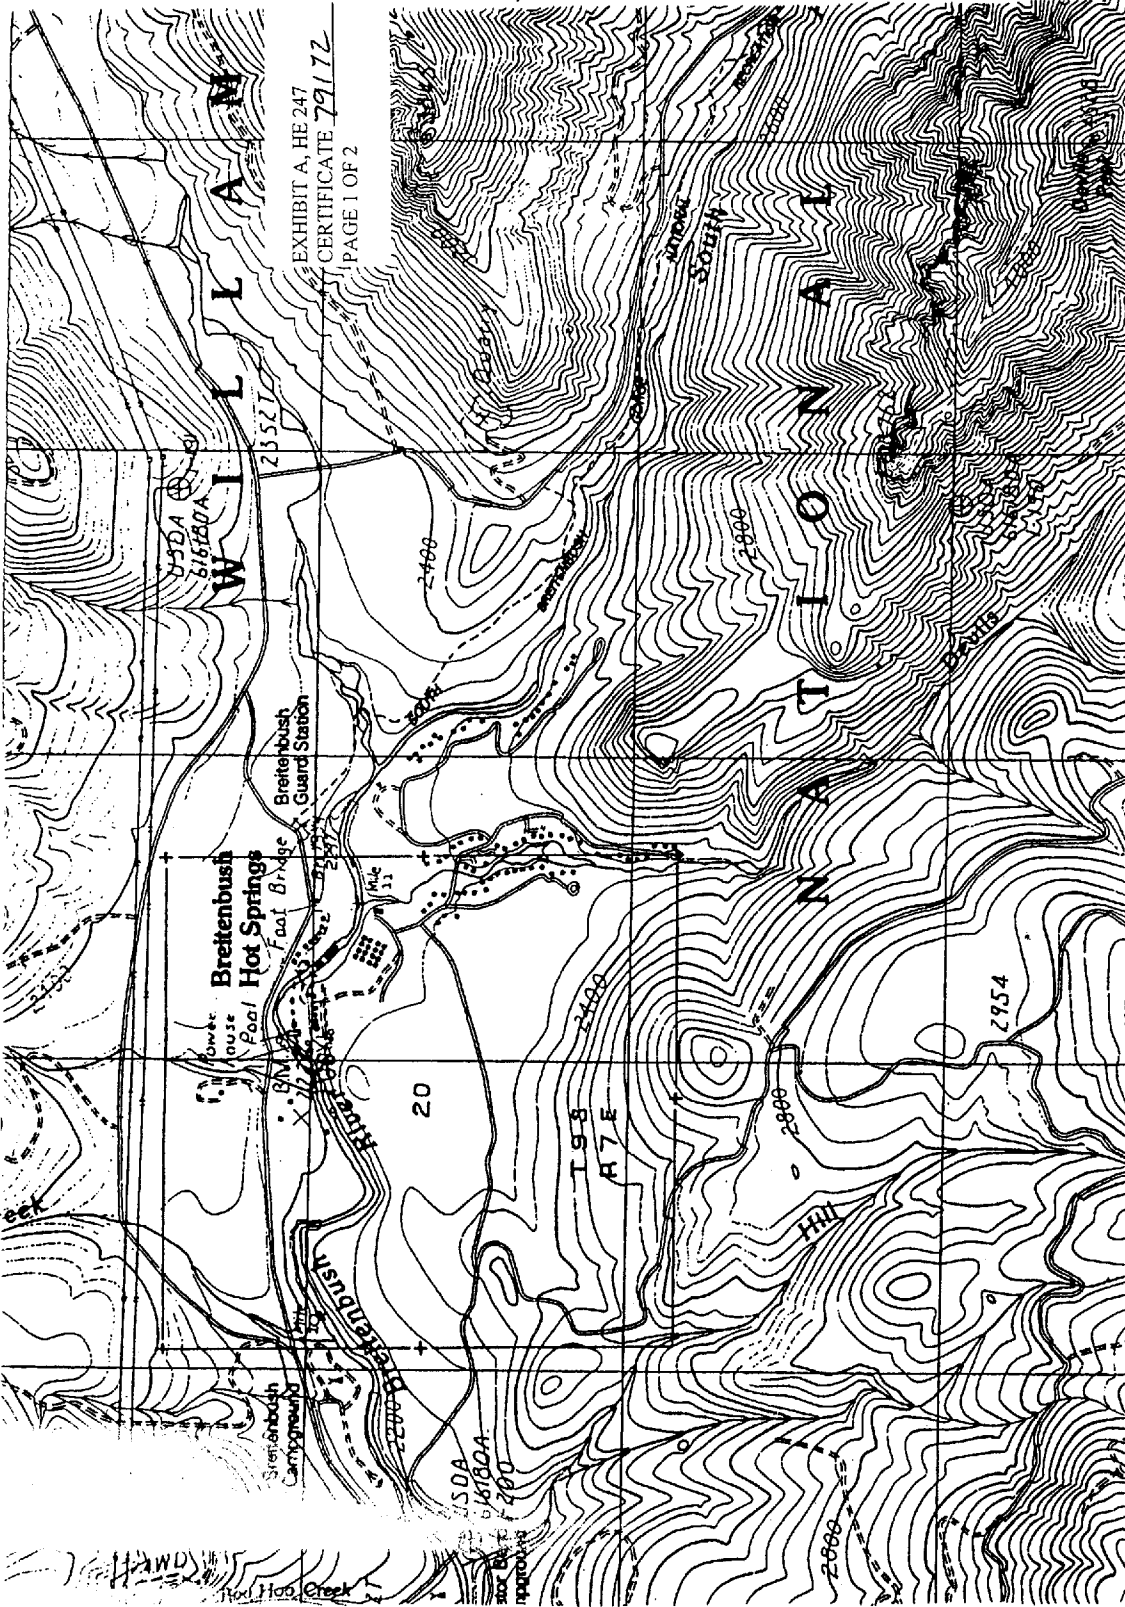


WATER RESOURCES DEPT.
SALEM, OREGON
FEB 27 1998

RECEIVED

RECEIVED
FEB 27 1998
WATER RESOURCES DEPT
SALEM OREGON

N
B
U
E
K

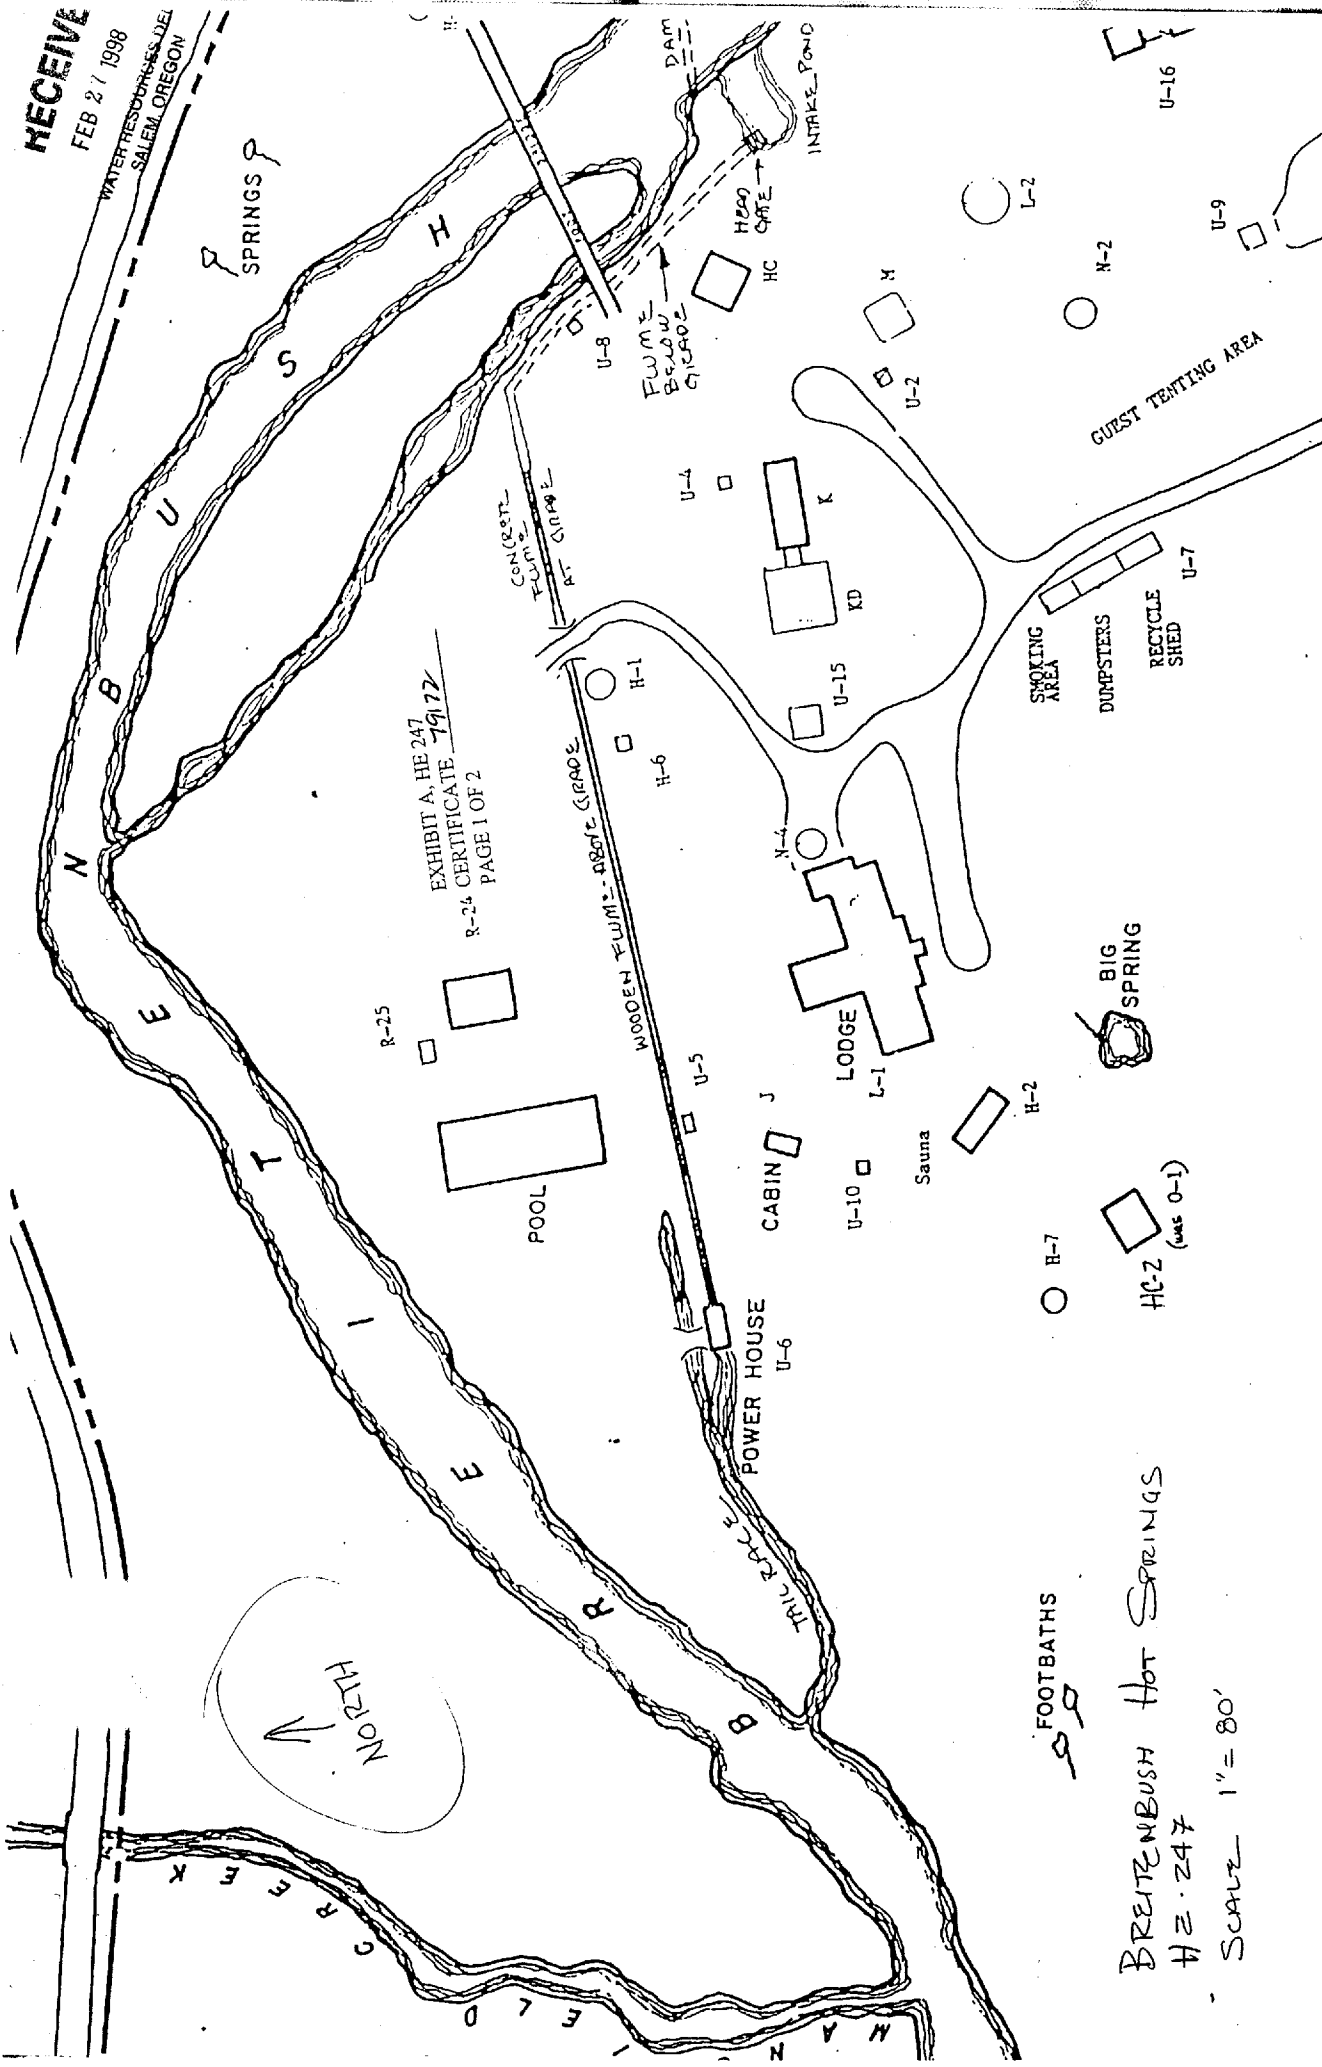

FOOTBATHS

BREITENBUSH HOT SPRINGS
AZ. 247

Scale $1'' = 80'$