



Tax Lot No. TL2900 23 12 20BD
Section 20 Township 23S Range 12W W.M.
Coos County

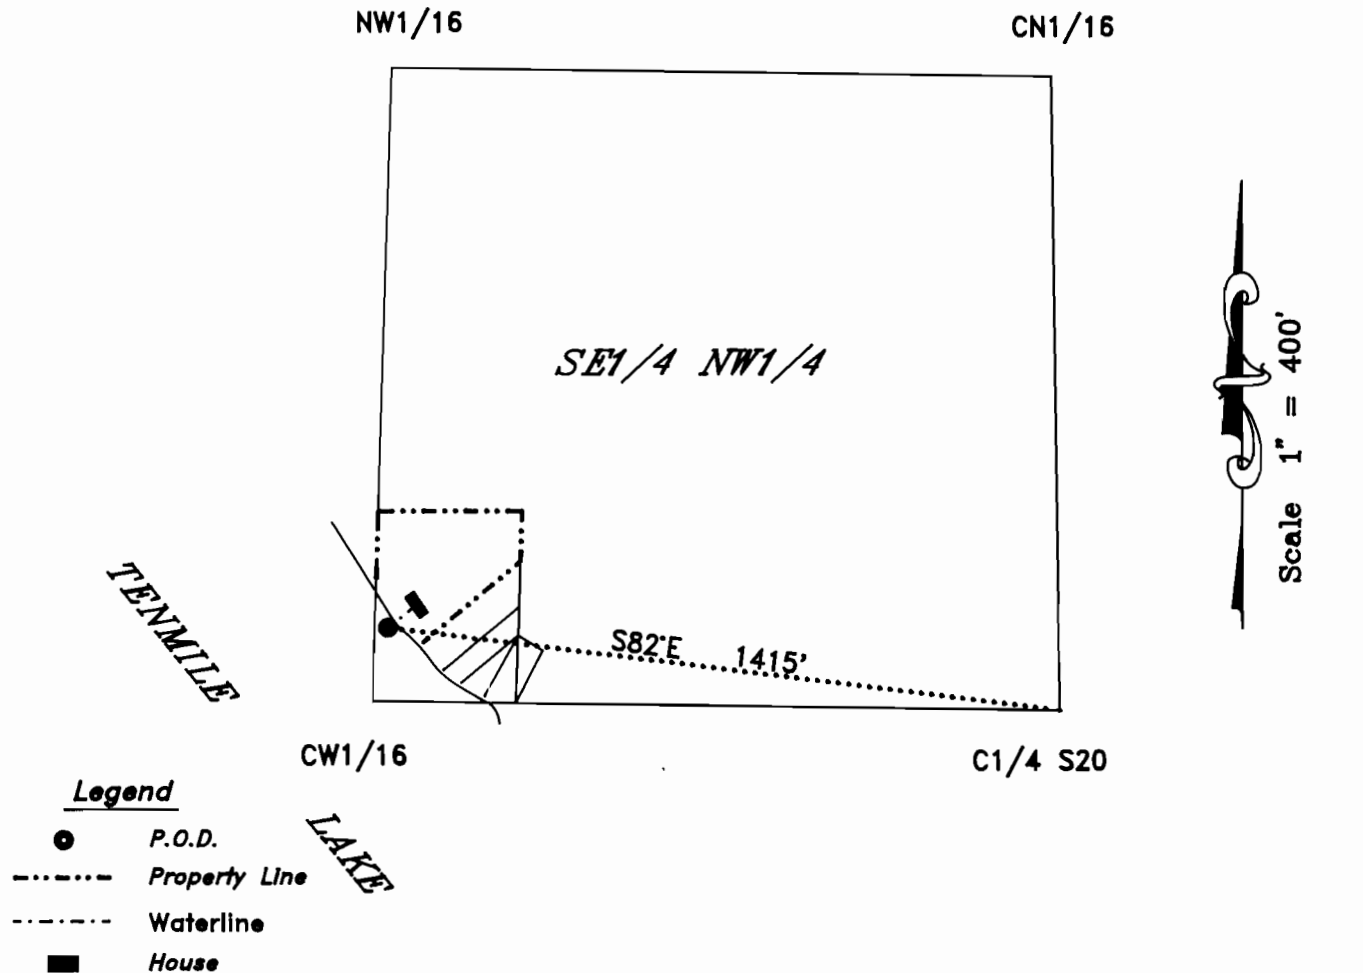

EXAMINERS DISCLAIMER STATEMENT

The preparation of this map was for the purpose of identifying the location of the Water Right only and has no intent to provide dimensions or location of property ownership lines.

FINAL PROOF SURVEY
IN THE NAME OF
Robert and Barbara Kruis

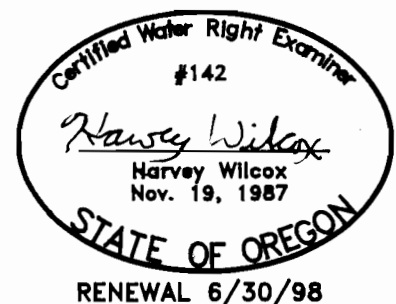

Surveyed on 8/26/97 by H.A. Wilcox

Application No. S-81387
Permit No. 53179