


RECEIVED
SEP. 3 1933
WATER RESOURCES DEPT.
SALEM, OREGON

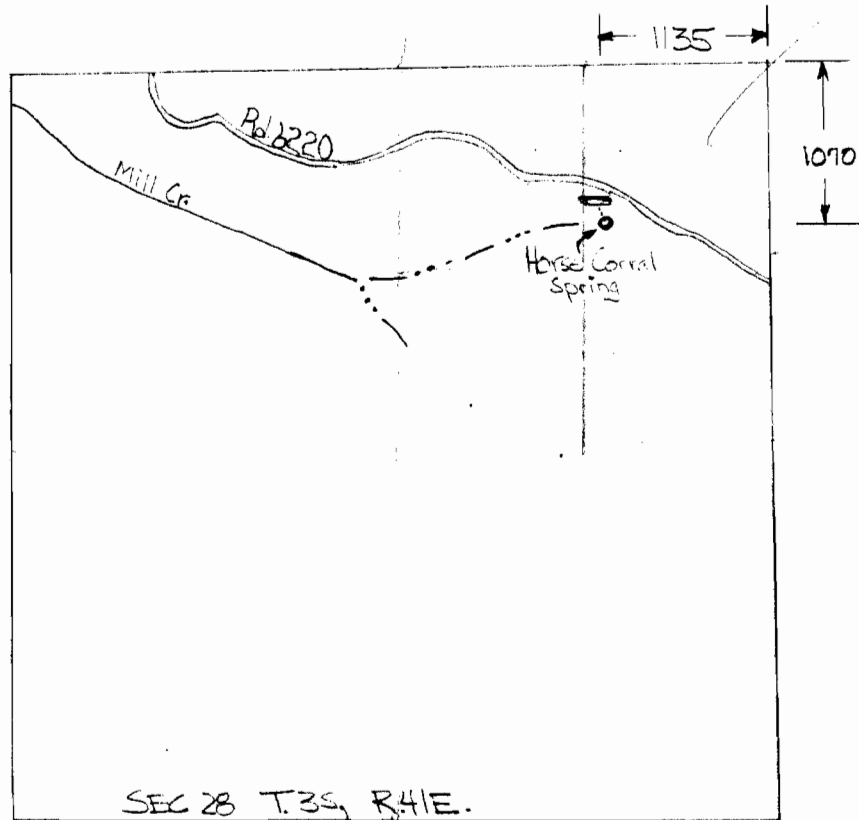

SCALE 4 INCHES = 1 MILE

↑ NORTH

Application No. 65954
Permit No. 53136