


N

RECEIVED

APR 29 1983

WATER RESOURCES DEPT
SALEM, OREGON

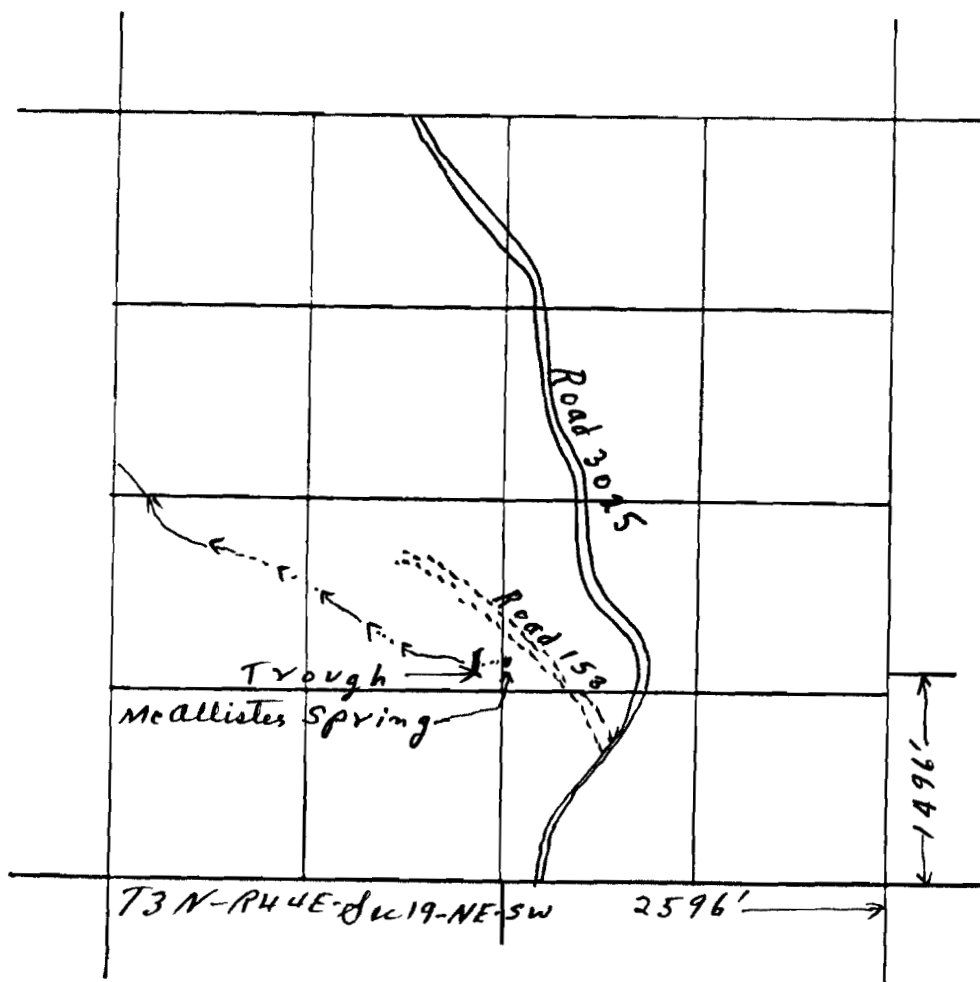

4 inches = 1 mile

Application No. 65741

Permit No. 49727