


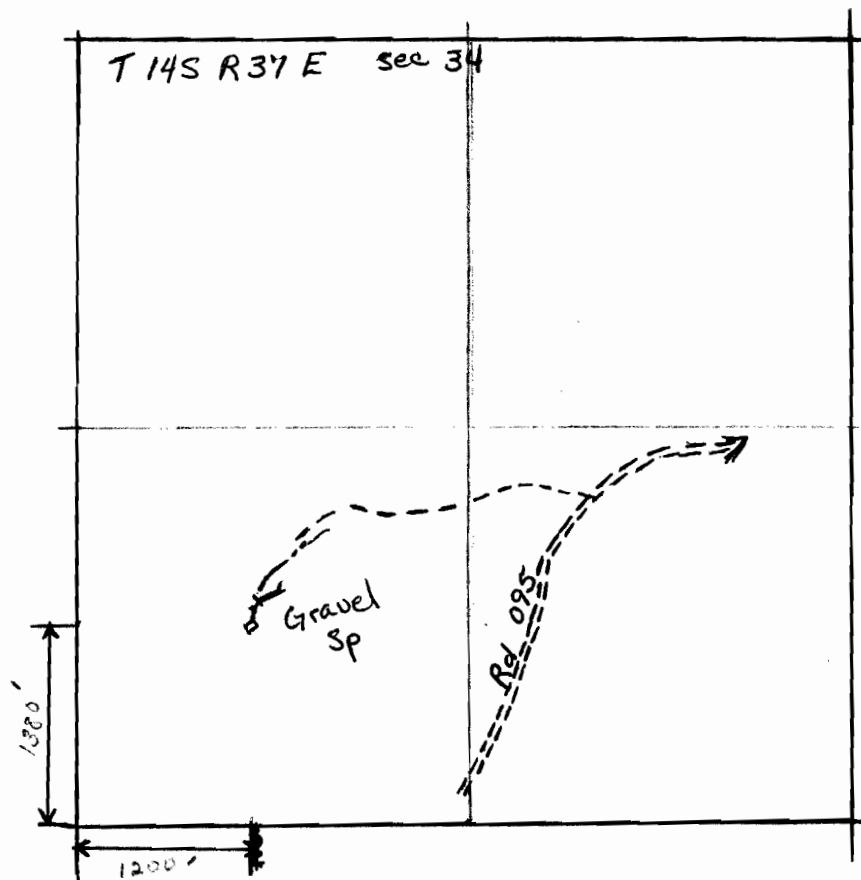

RECEIVED
SEPS 1993
WATER RESOURCES DEPT.
SALEM, OREGON

Application No. 65924
Permit No. 50508