


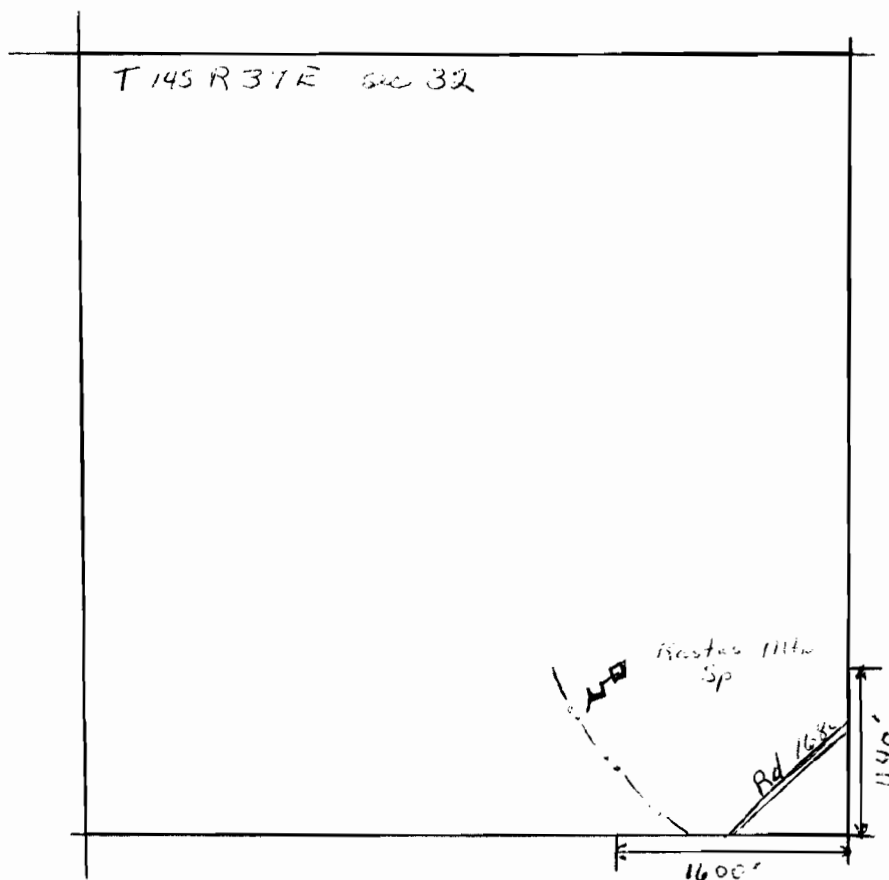

RECEIVED

SEP 6 1983
WATER RESOURCES DEPT.
SALEM, OREGON

Application No. 65934
Permit No. 50518