


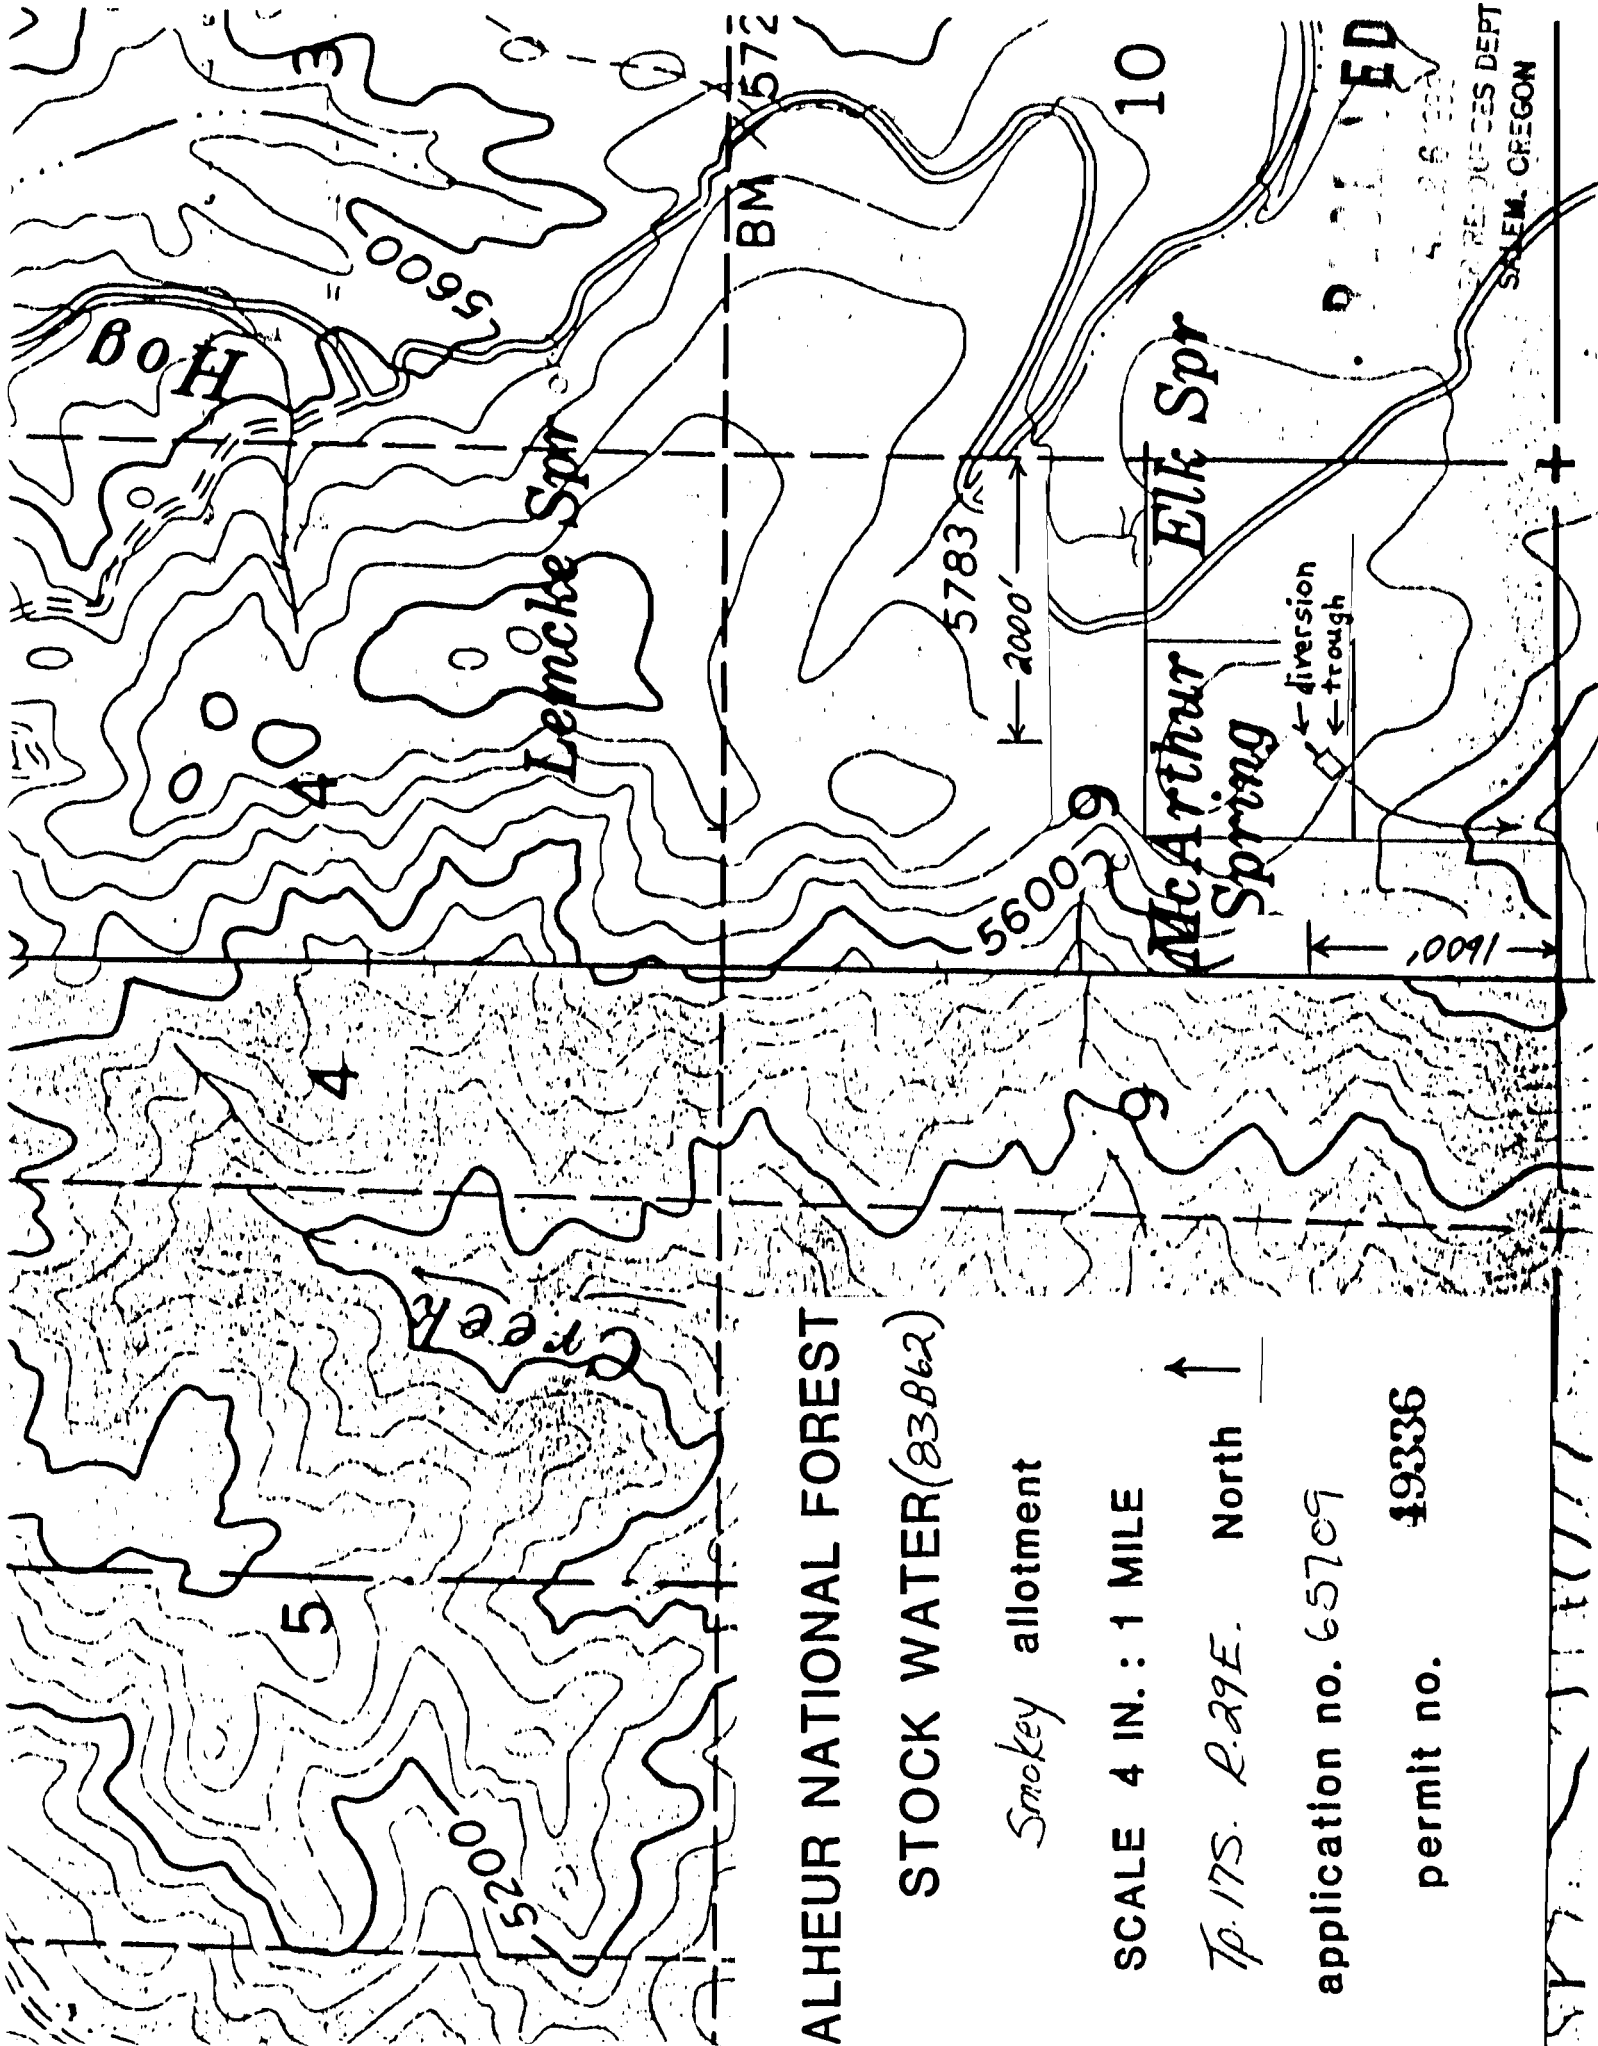

ALHEUR NATIONAL FOREST

STOCK WATER (83862)

Smokey allotment

SCALE 4 IN. : 1 MILE

Tp. 17S. R. 29E. North ↑

application no. 65709

permt no. 49336

RECEIVED
Salem, Oregon