


SECTION

30 SW SW

TOWNSHIP 27 S; RANGE 30 E, W. M.

North

#4849- Mazzoni Spring

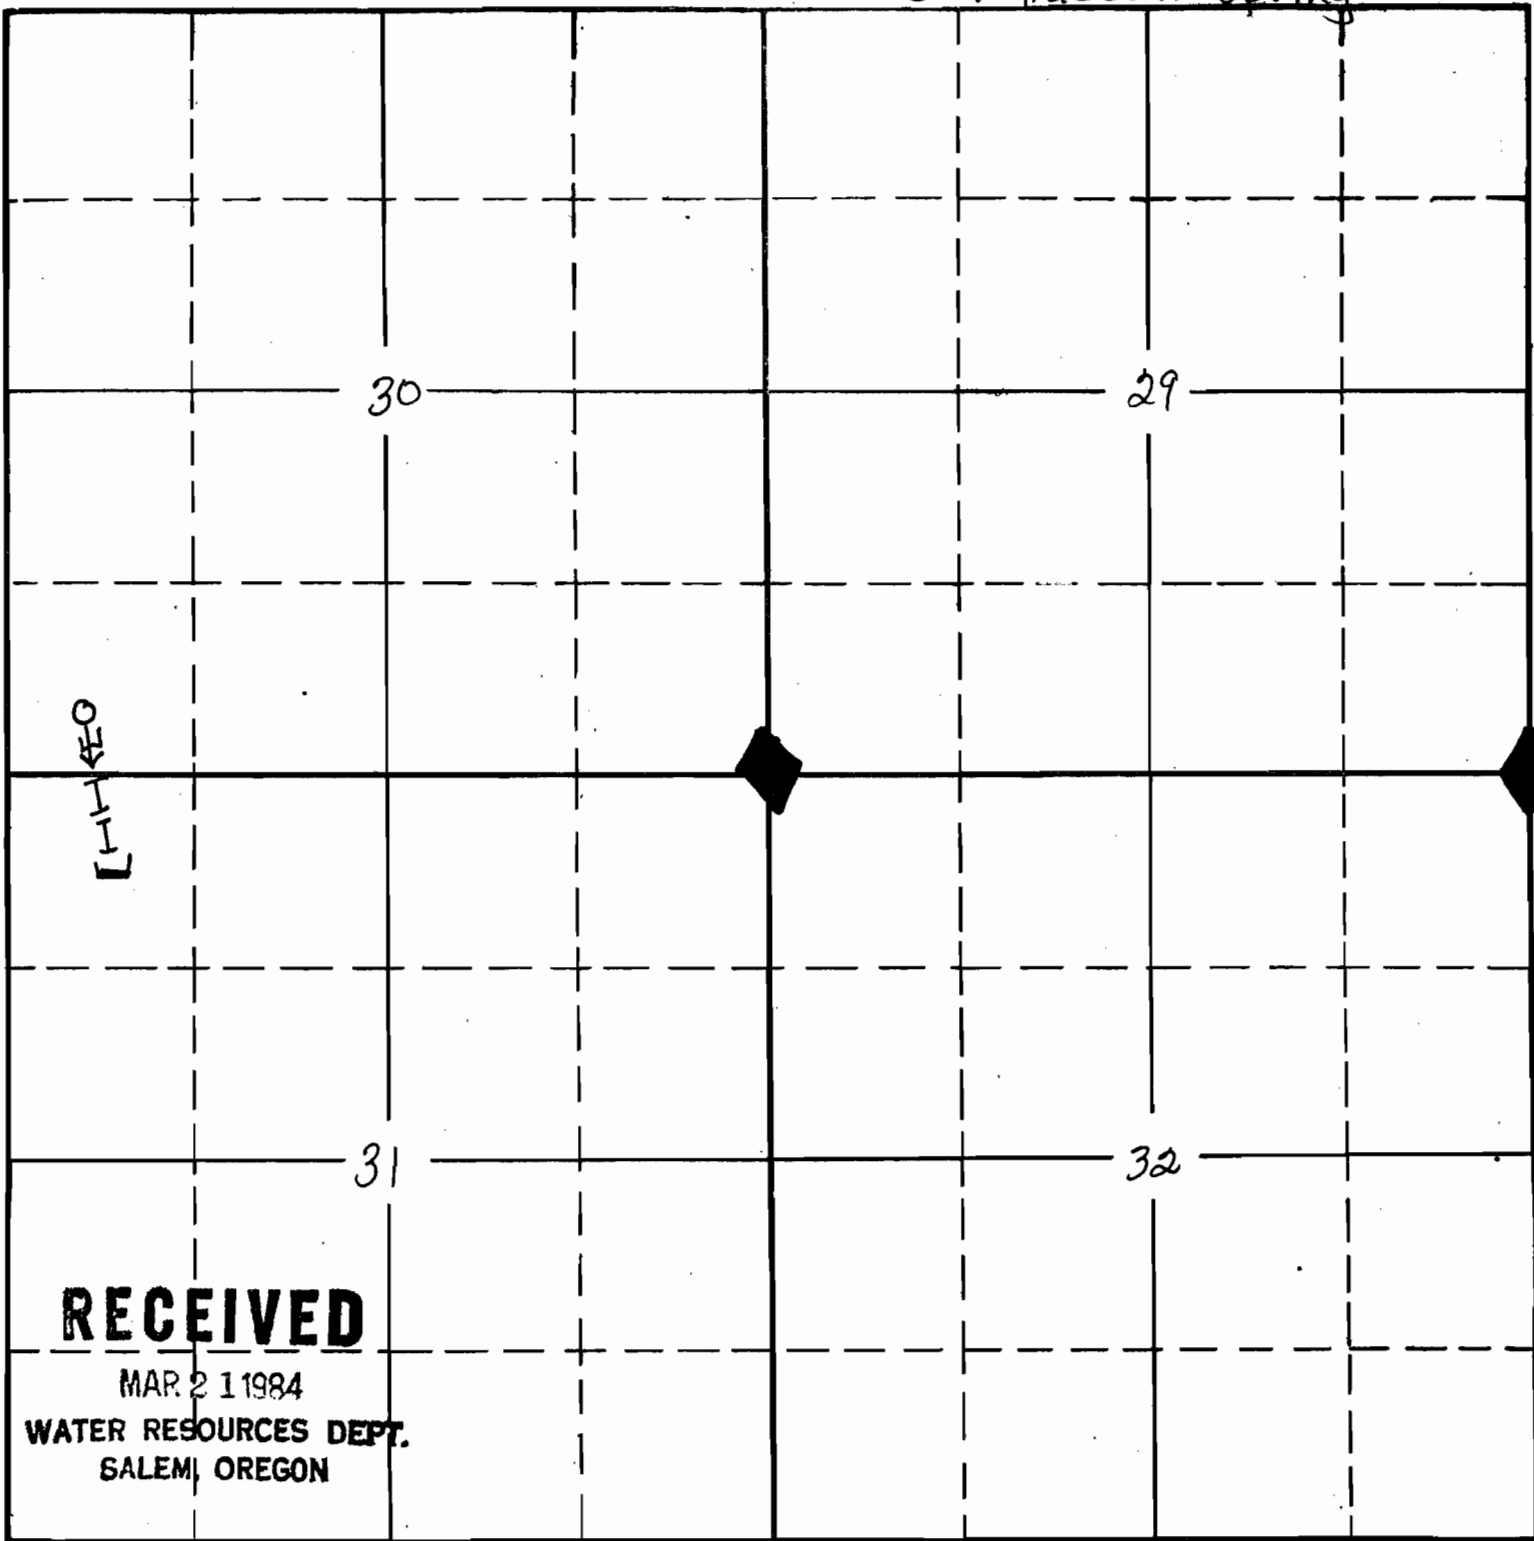

South

APPLICATION No.
PERMIT No.

SALEM, OREGON
WATER RESOURCES DEPT.
SALEM, OREGON

Application No. 66/20
Permit No. 48355