

MORROW CC

" = 2000,


SEE MAP 5S 26

SEE MAP 5S 25

FIRST

STANDARD

SEE MAP 5S 26

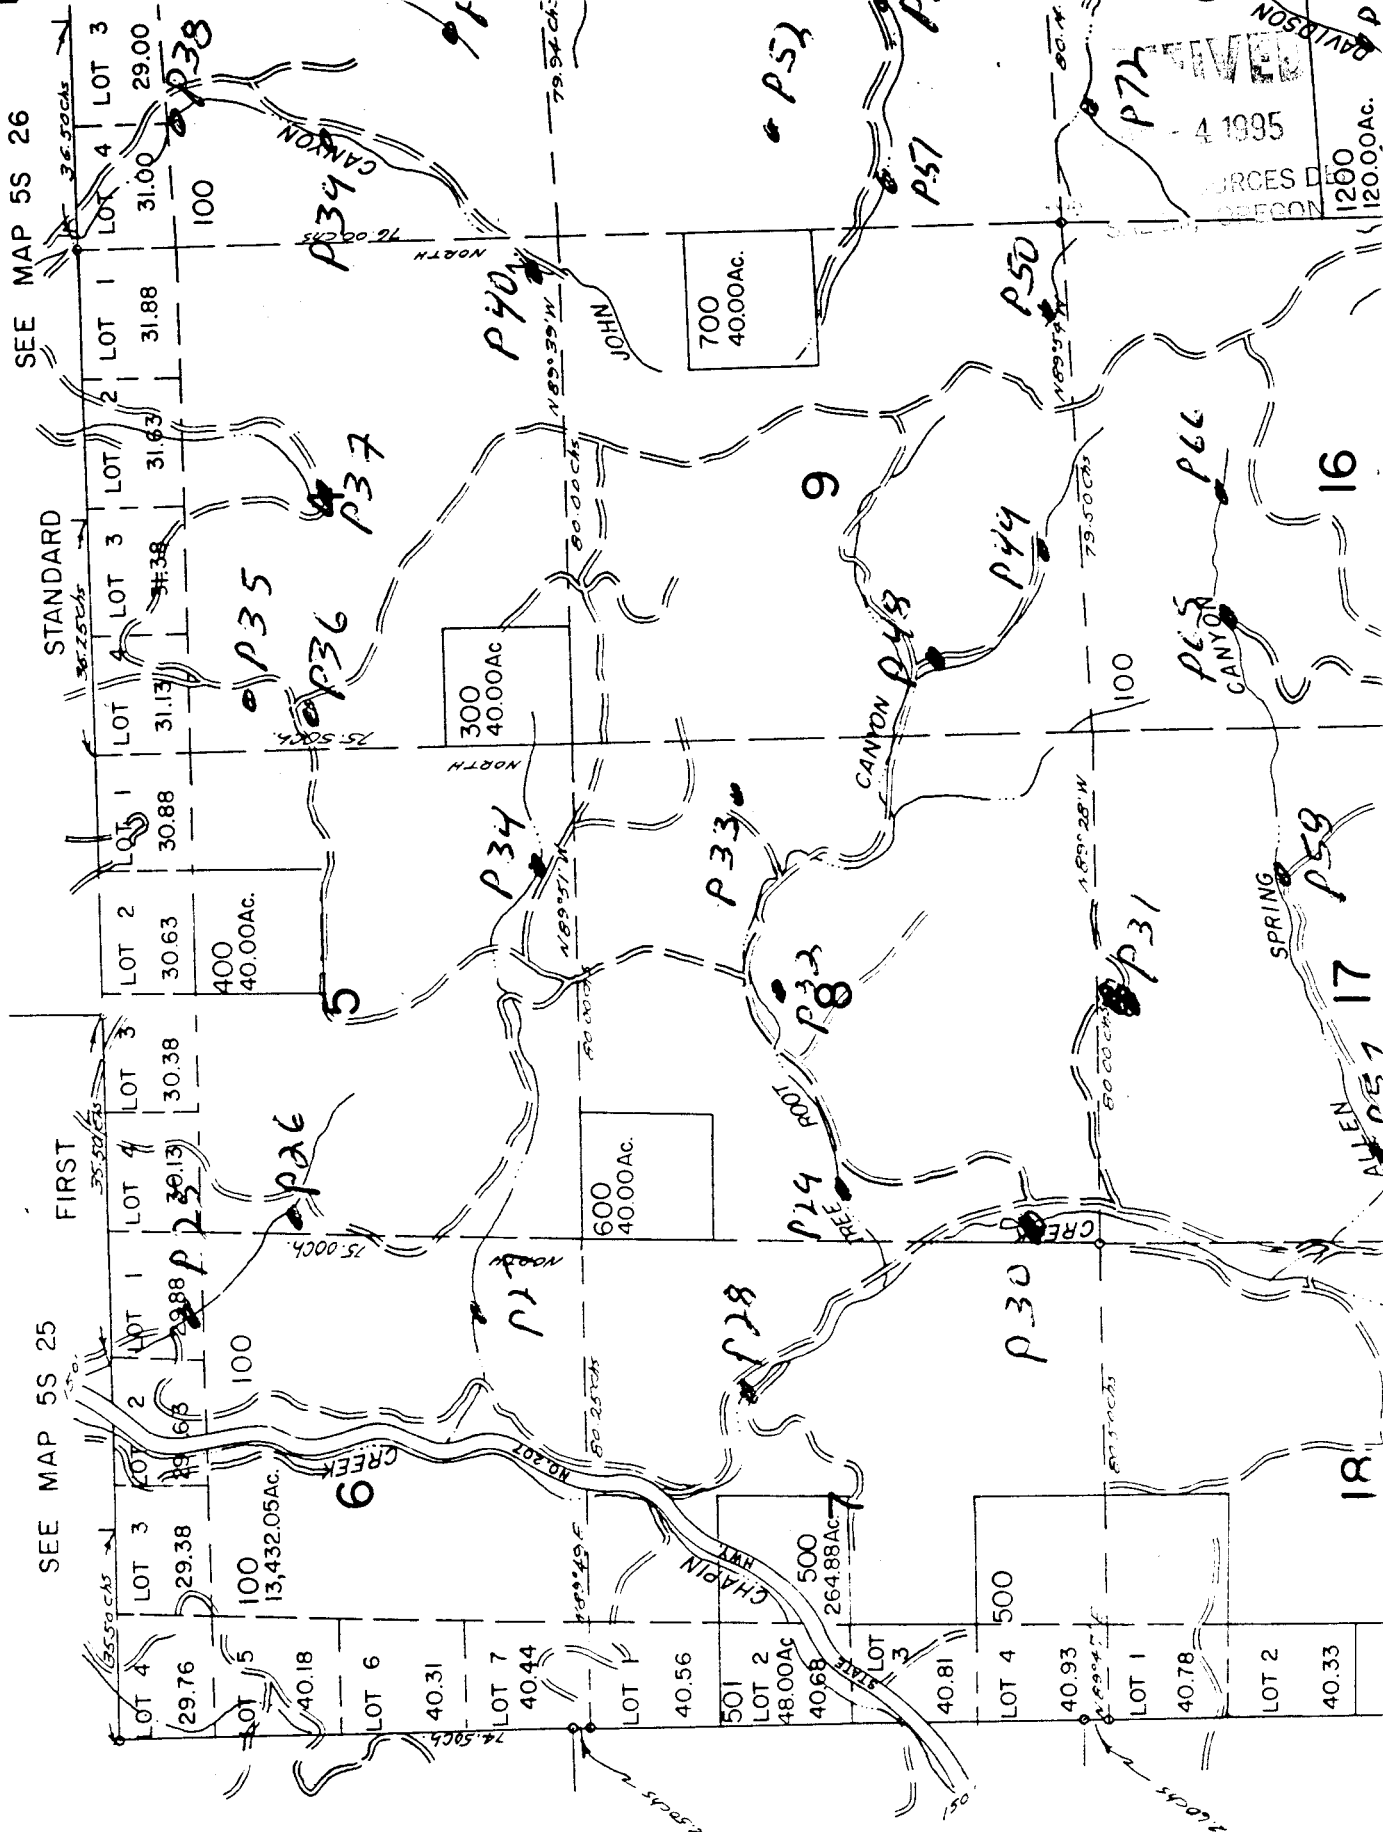

Application No.
Permit No.


R. 79895

71665

JAN - 4 1995

WATER RESOURCES DEP
7 SALEM, OREGON

0122

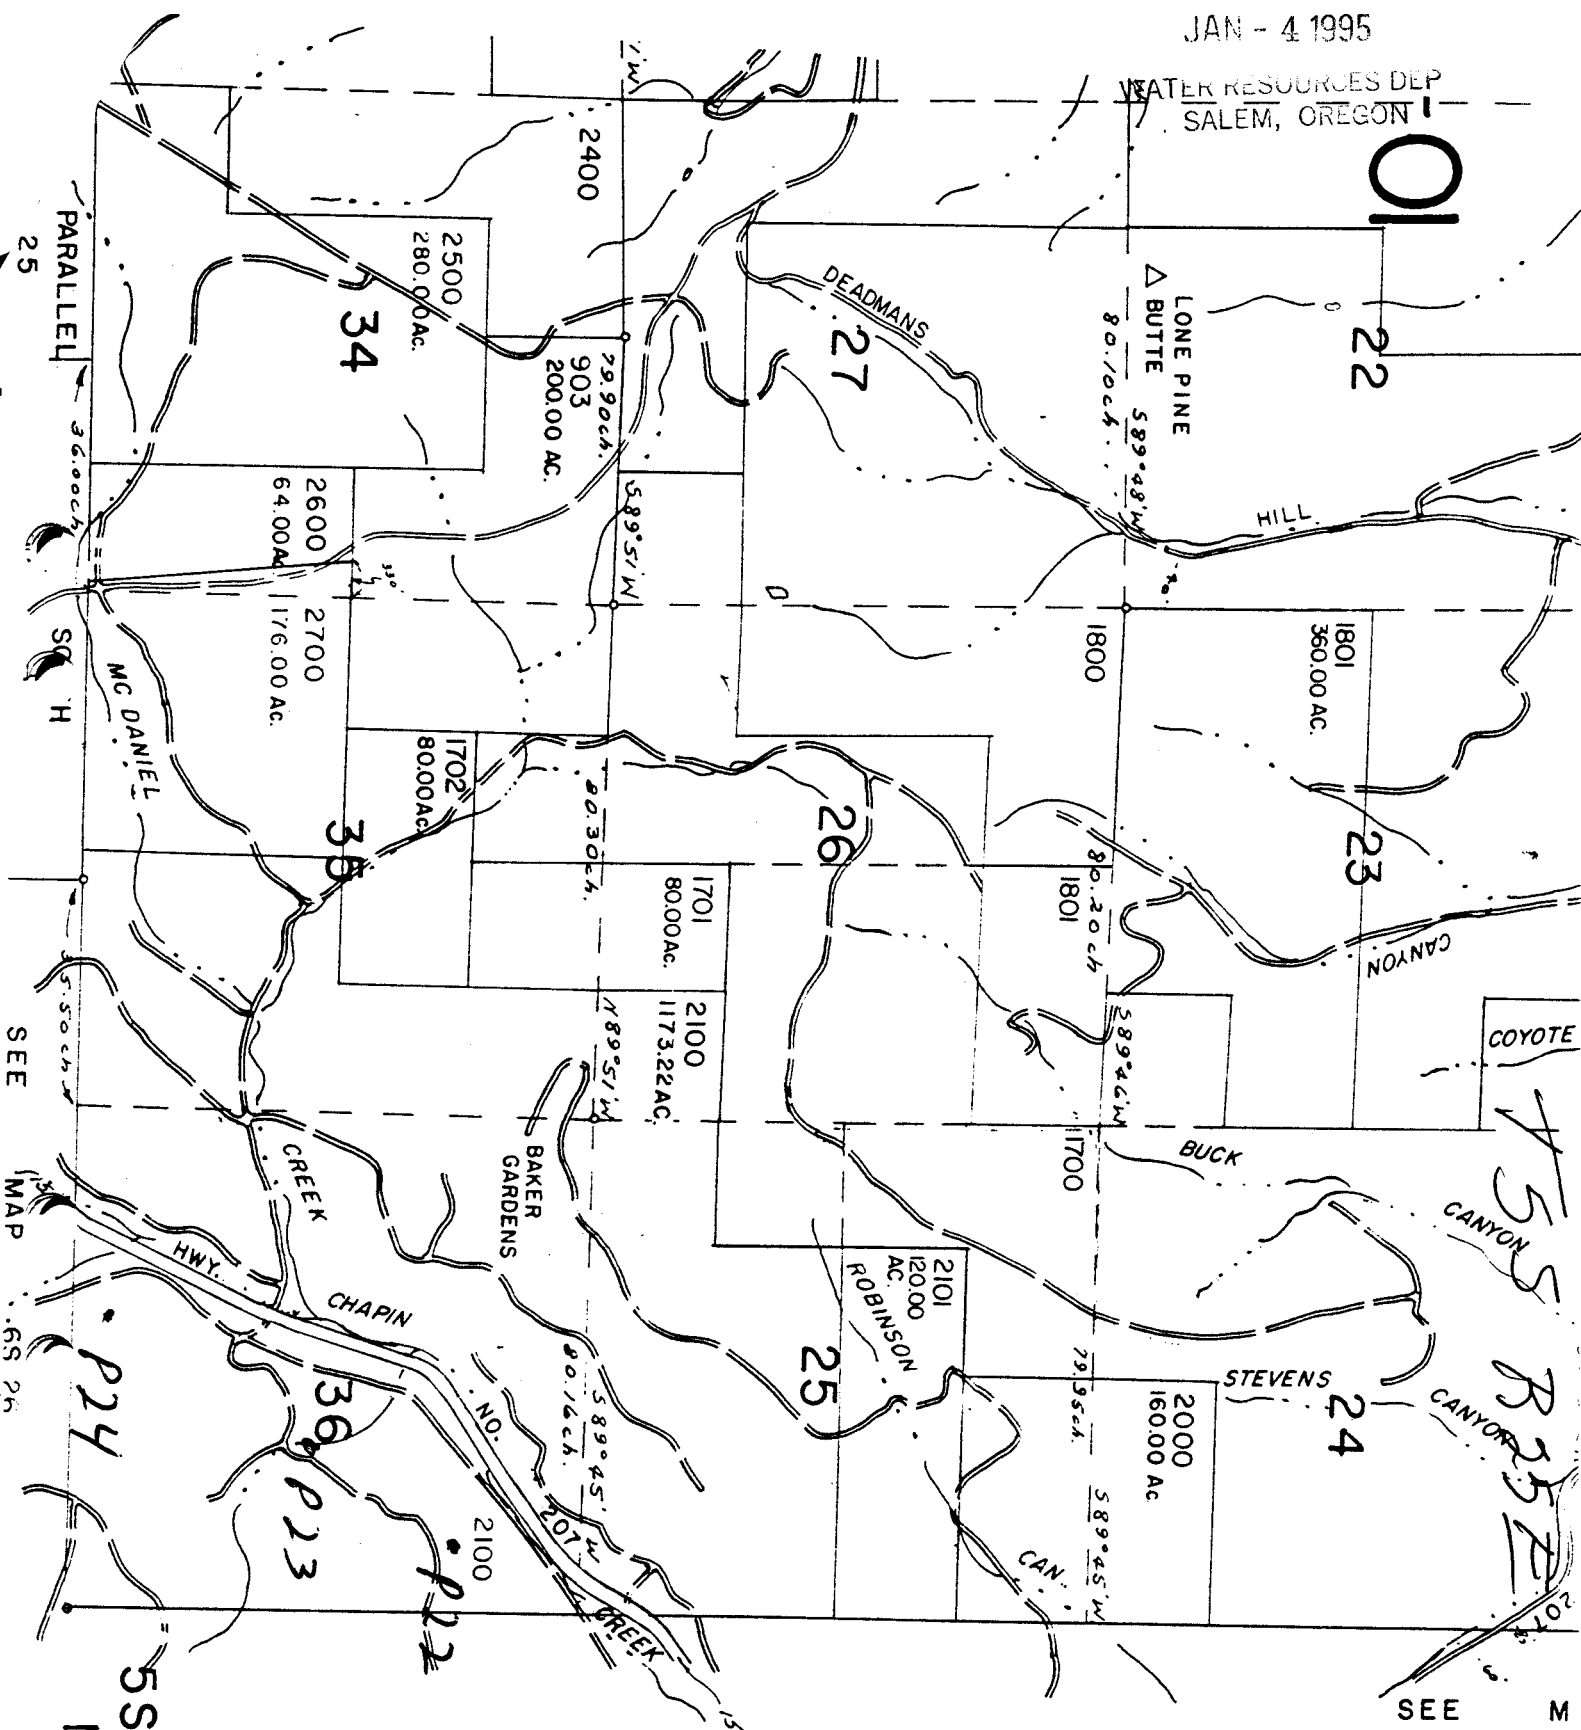

SEE M

71665

Application No. _____
Permit No. _____

R 79895

55 25 8
INDEX

