


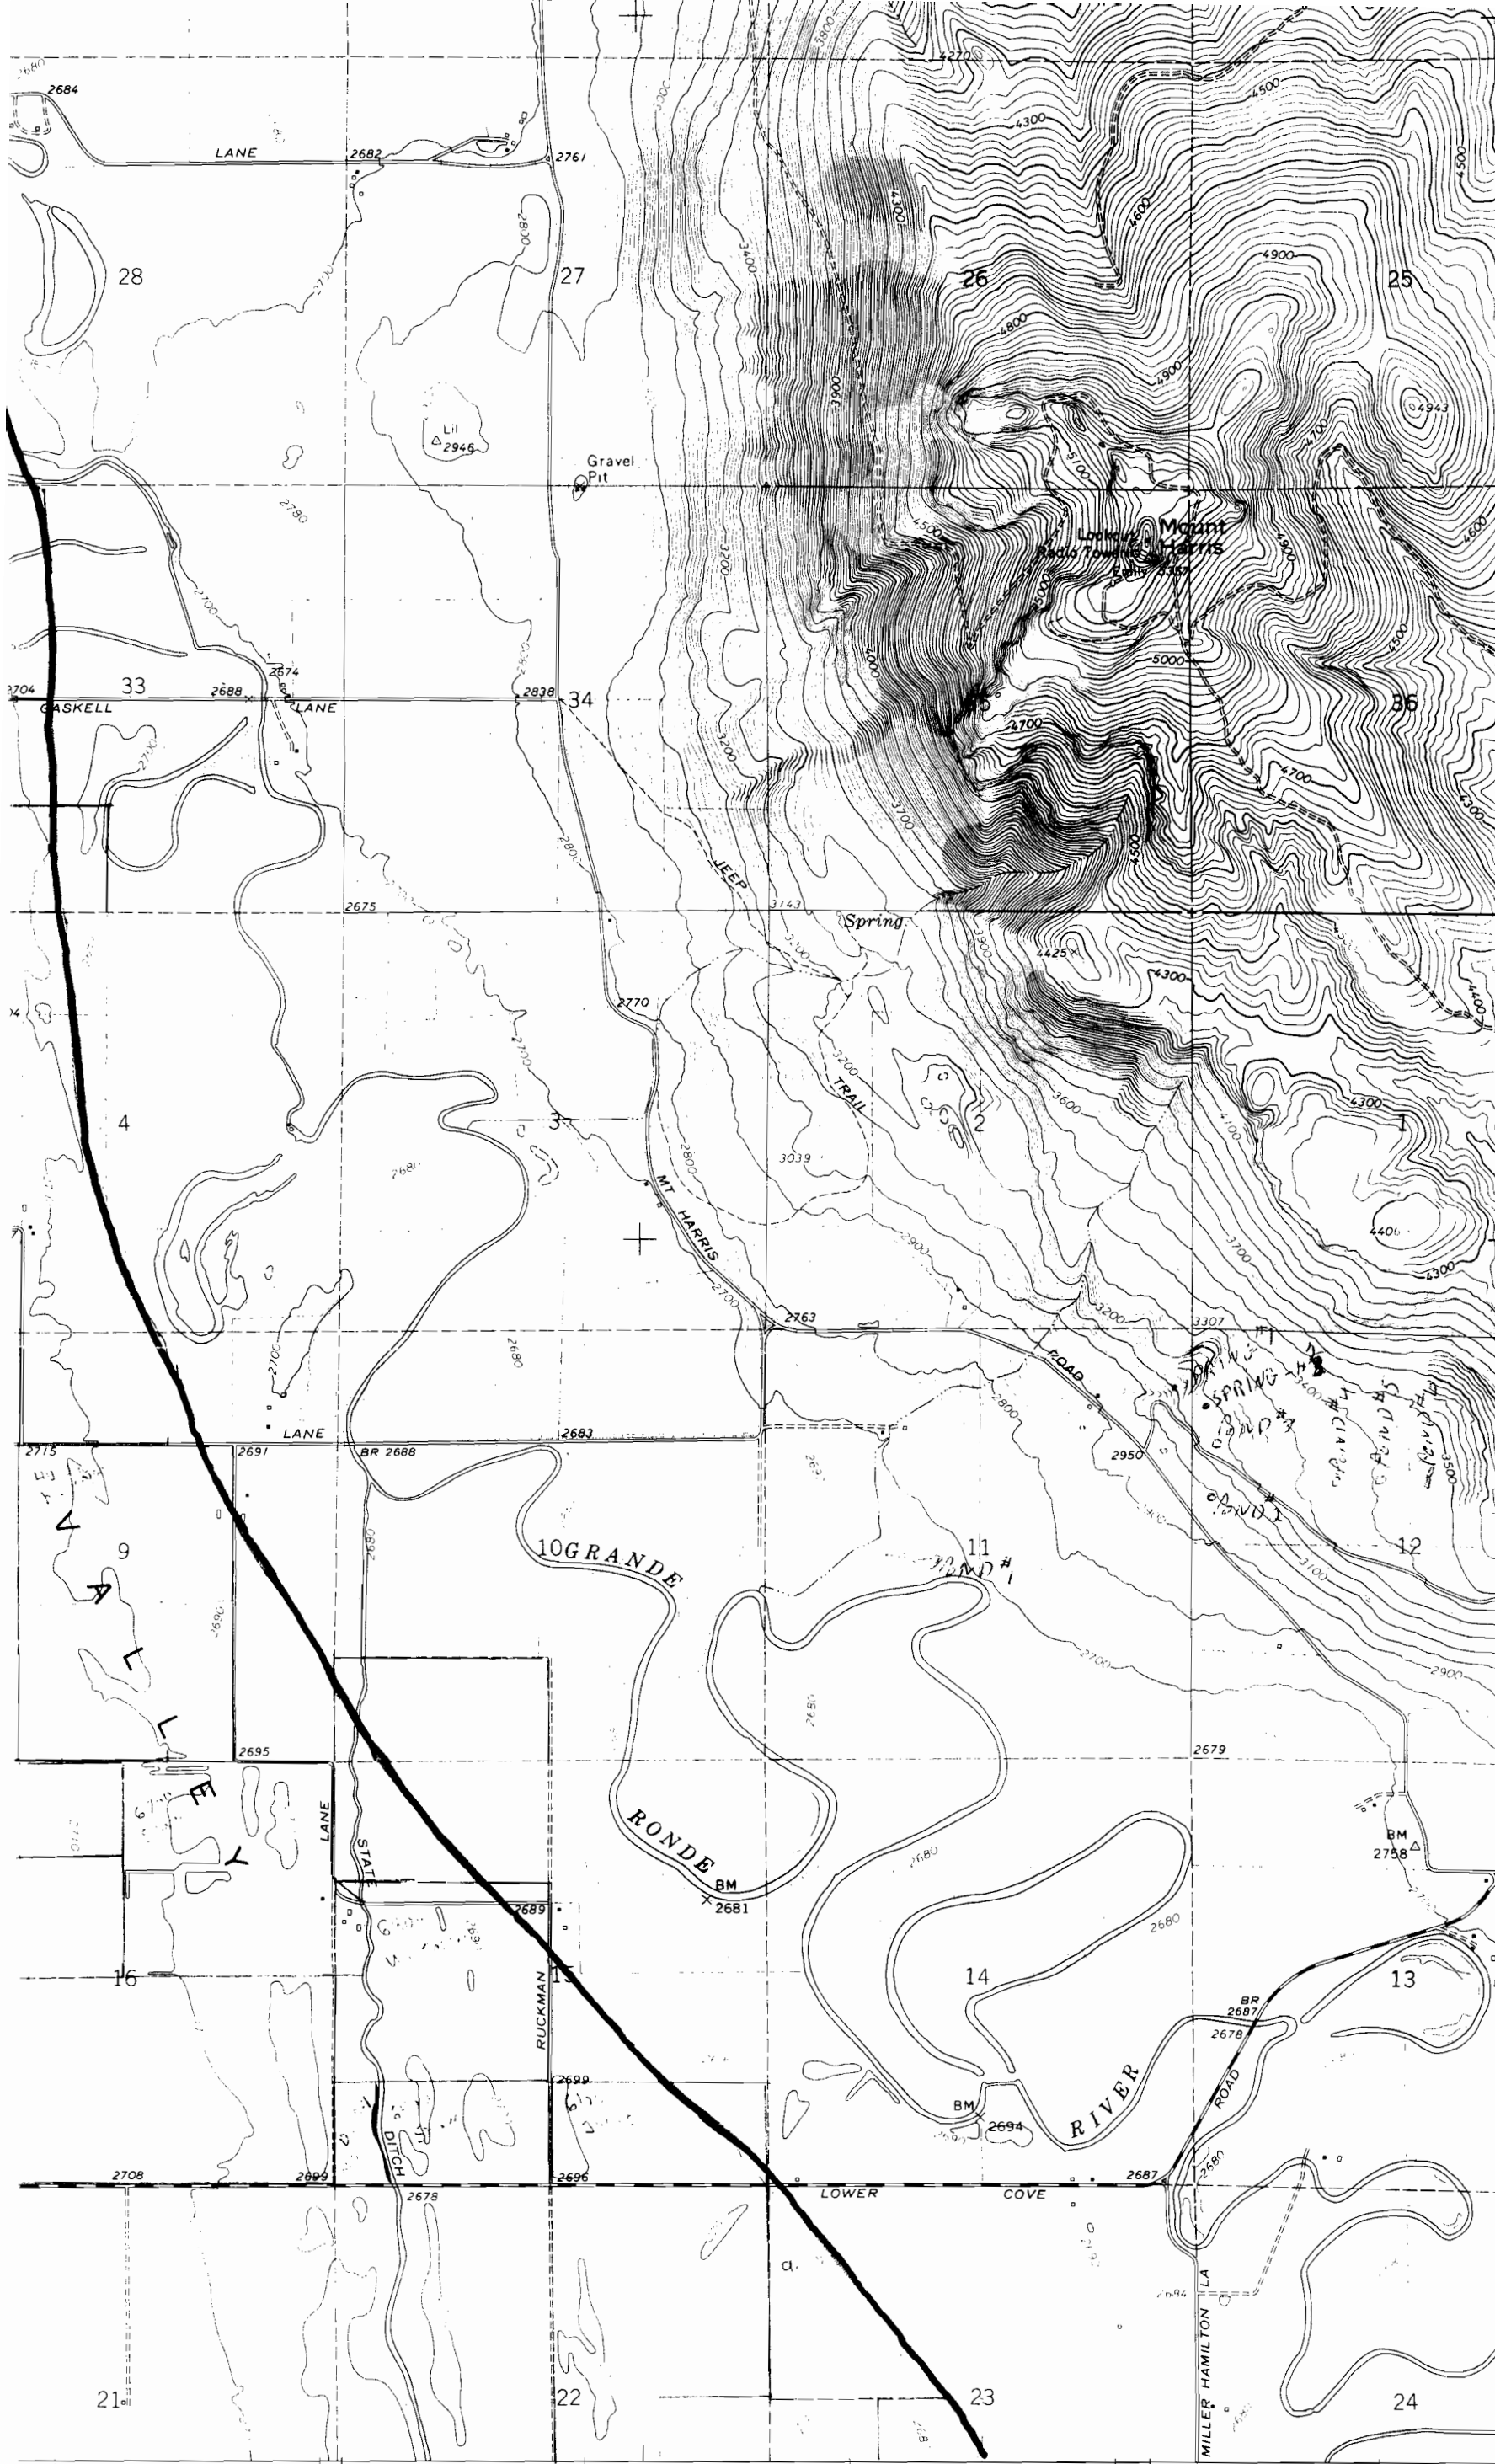

27°30" 5034
5033
5032
5031
T. 1 S
T. 2 S
5030
25'
5029
5028
5027
5026
5025 000m N.
45°22'30"
117°52'30"
2474 IV SE
69441 DEC 1994
WATER RESOURCES DEPT.
SALEM, OREGON
"CERTIFICATE NO."

Township 15 - Range 39

SCALE 1:24 000

1 MILE

1 KILOMETER

CONTOUR INTERVAL 20 FEET
OTTED LINES REPRESENT 10-FOOT CONTOURS
DATUM IS MEAN SEA LEVEL


ROAD CLASSIFICATION

Medium-duty Light-duty
Unimproved dirt

State Route

OREGON

R75245

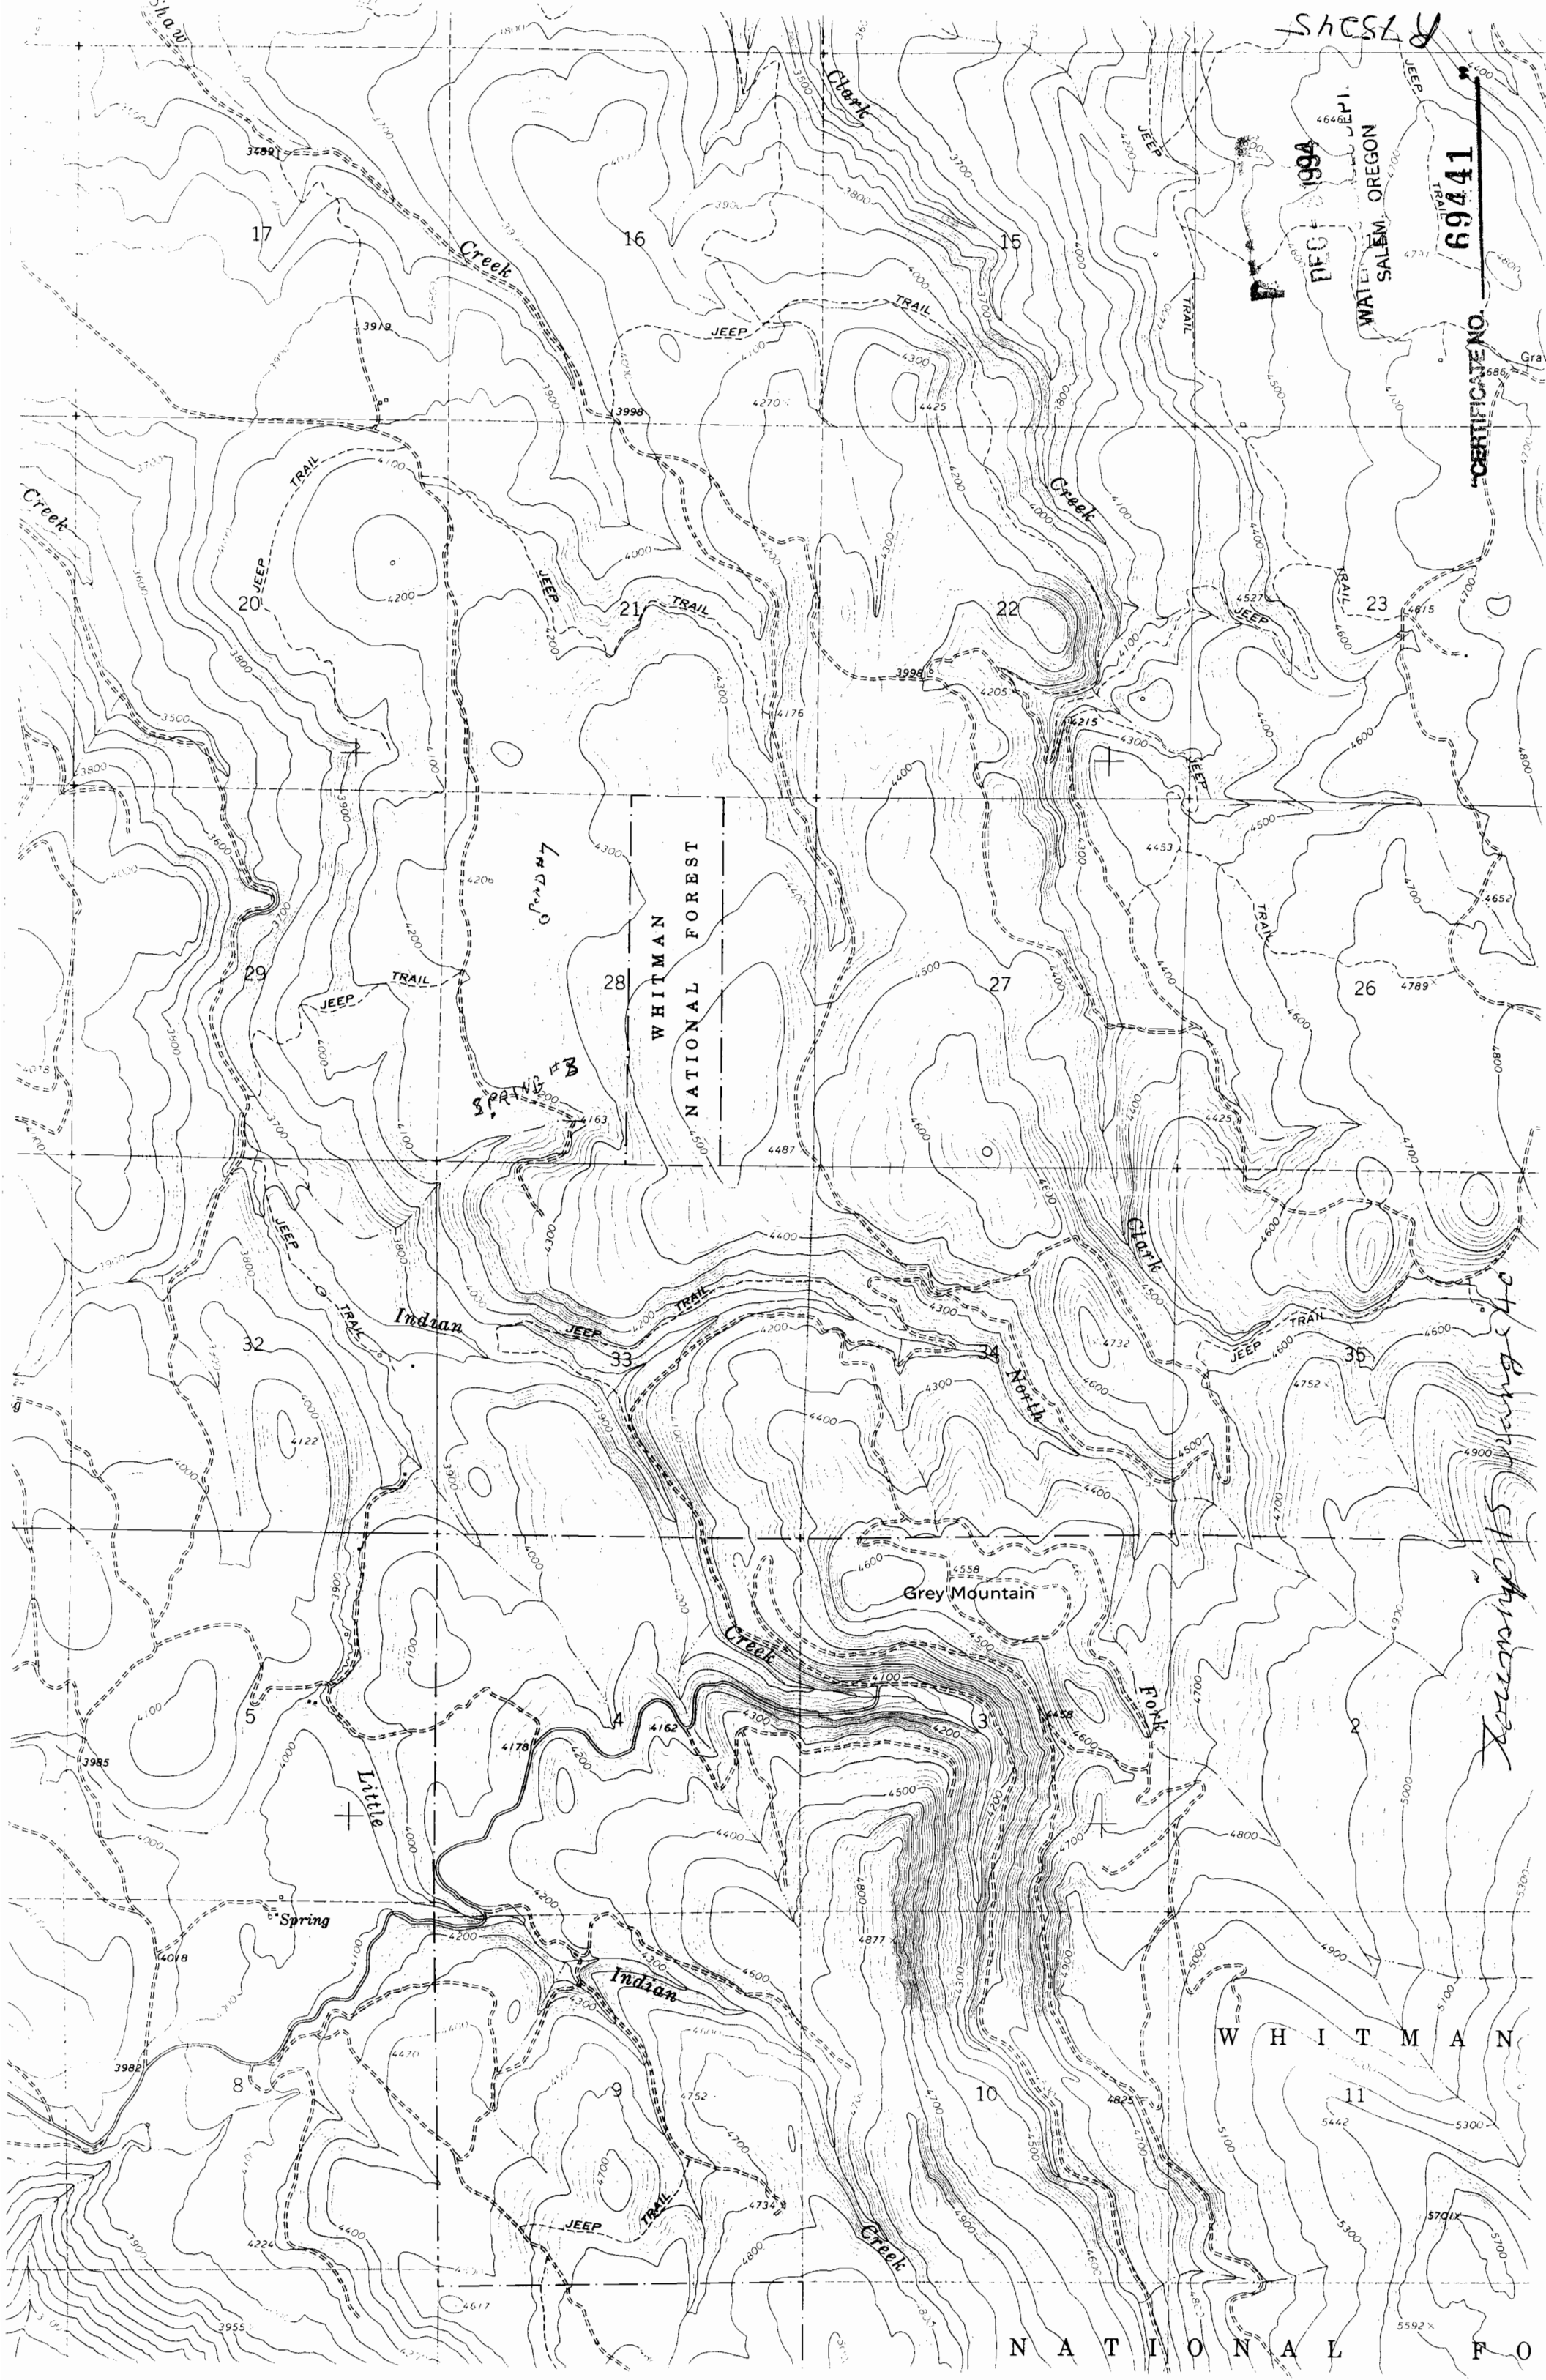

SHECSLY

DEC 1994

CERTIFICATE NO. 69441

WATER SALEM, OREGON

WHITMAN NATIONAL FOREST

Grey Mountain

W H I T M A N

NATIONAL FOREST

