


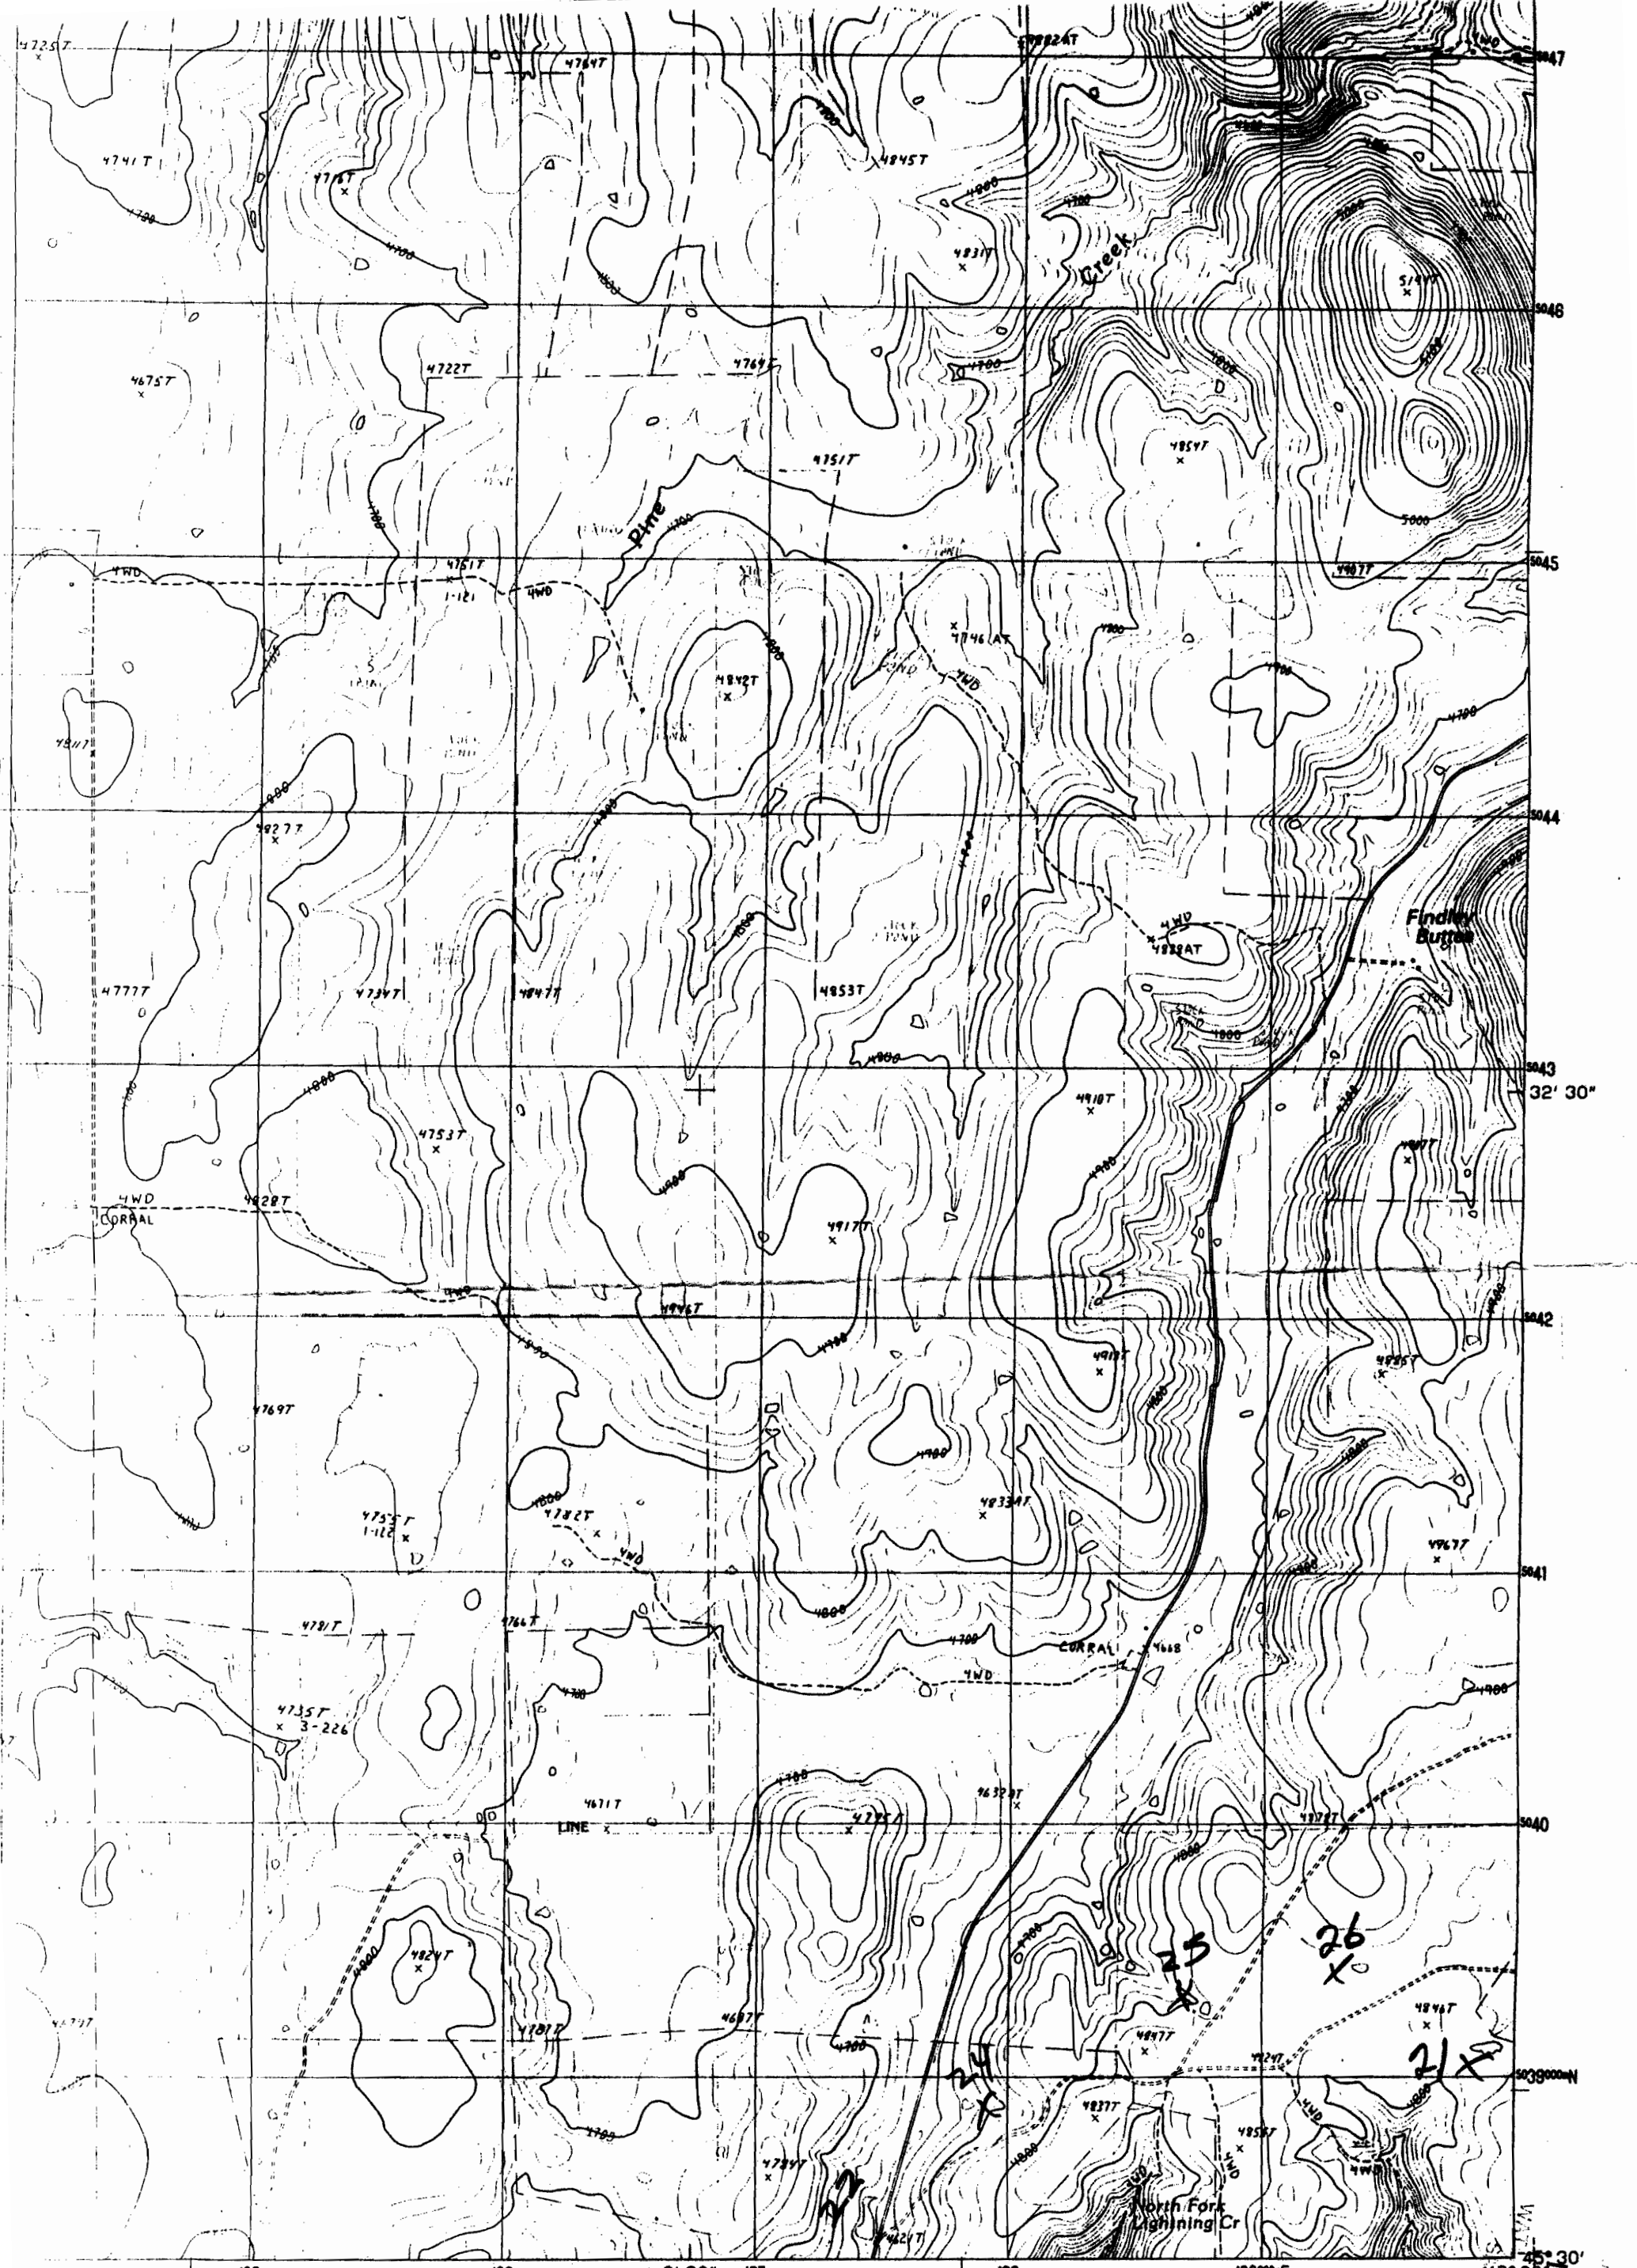

SCALE 1:24 000

INTERIOR - GEOLOGICAL SURVEY, RESTON, VIRGINIA - 1990

OREGON

QUADRANGLE LOCATION

ROAD LEGEND

Improved Road
Unimproved Road
Trail

○ Interstate Route ○ U. S. Route ○ State Route

CONTOUR INTERVAL 20 FEET

"CERTIFICATE NO.

70082

R-76095

1	2	3
4	5	

1 Roberts Butte
2 Greenwood Butte
3 Zumwalt
4 Elk Mountain
5 Findley Butte

To convert meters to feet multiply by 3.2808
To convert feet to meters multiply by .3048

ELK MOUNTAIN SE OREGON

DEC 27 1994

