


T.37S.R.1W.W.M.

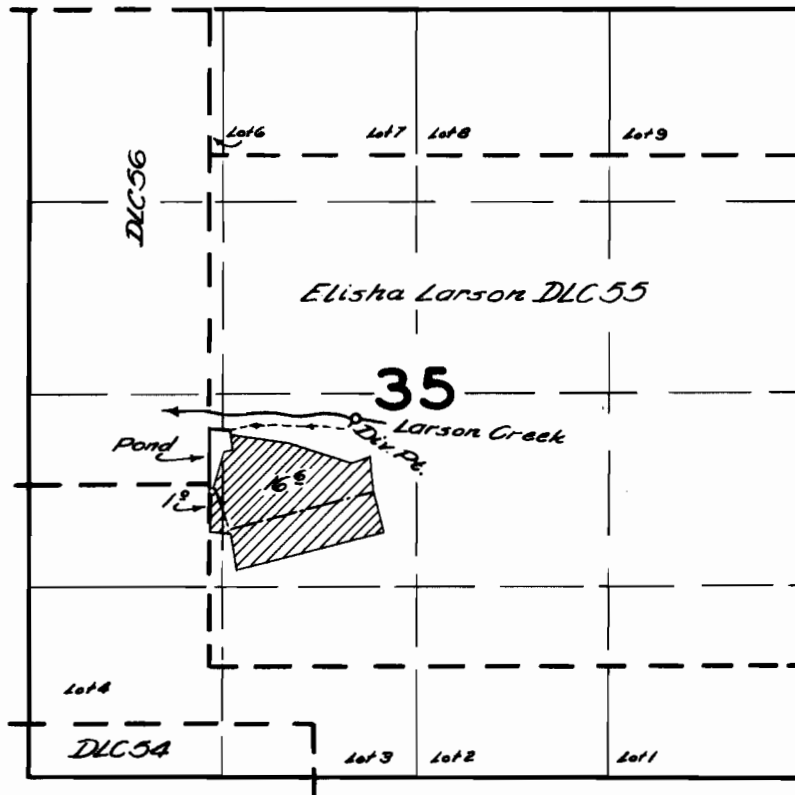

FINAL PROOF SURVEY
UNDER

Application No. ^{R-26969} 26970... Permit No. ^{R-1585} 22729...
IN NAME OF

.....*Oscar J. Gysin*.....

Surveyed *May 18* 1959, by *C.O. Bartle*.....