


# T. 38 S., R. 1 W., W.M.

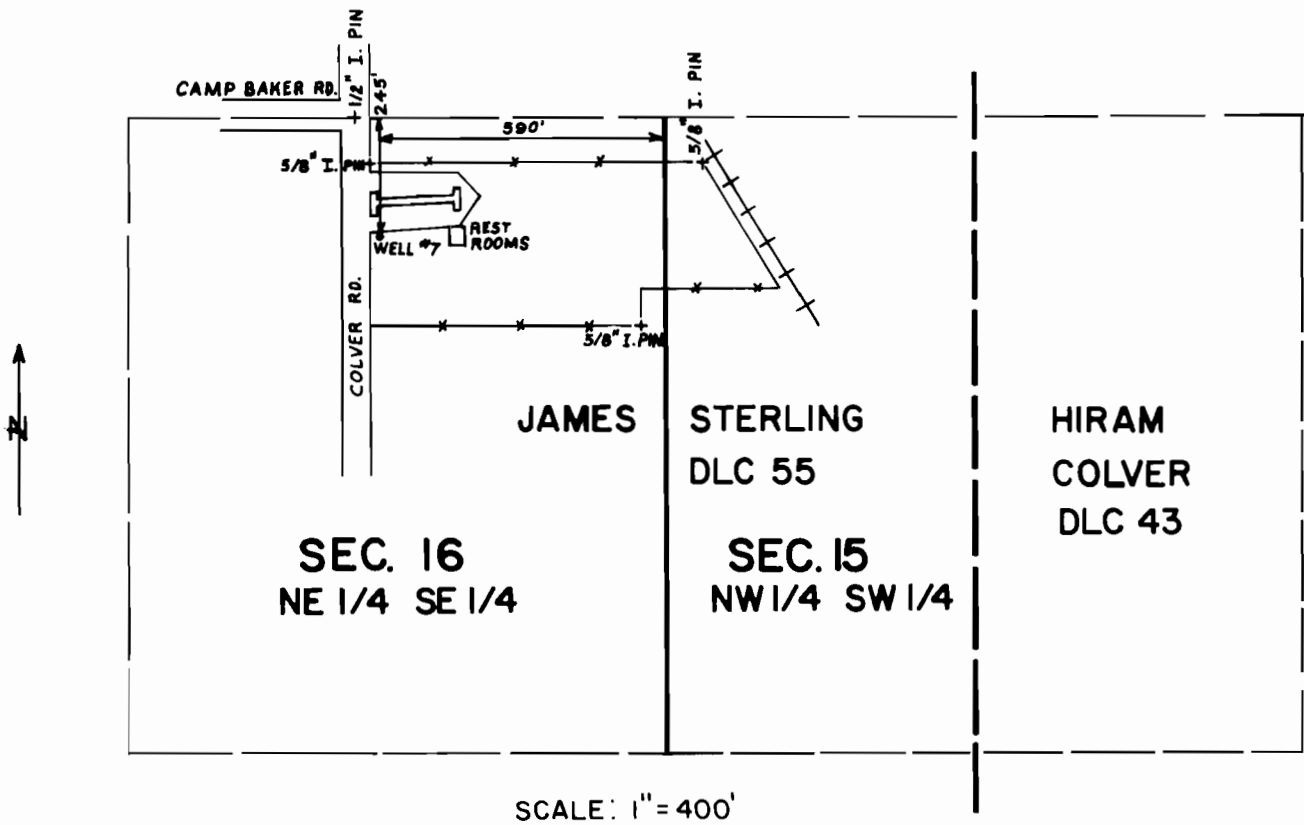

## FINAL PROOF SURVEY UNDER

Application No. G-6009 Permit No. G-6827  
IN NAME OF

CITY of PHOENIX

Surveyed FEB. 28. 1984, by B.S. JAMES