


SW 1/4 OF THE NW 1/4
SECTION 24
T2S, R4E, WM
CLACKAMAS COUNTY, OREGON

MAY 25 1997

MAINTAINED SURCES
CLACKAMAS COUNTY, OREGON

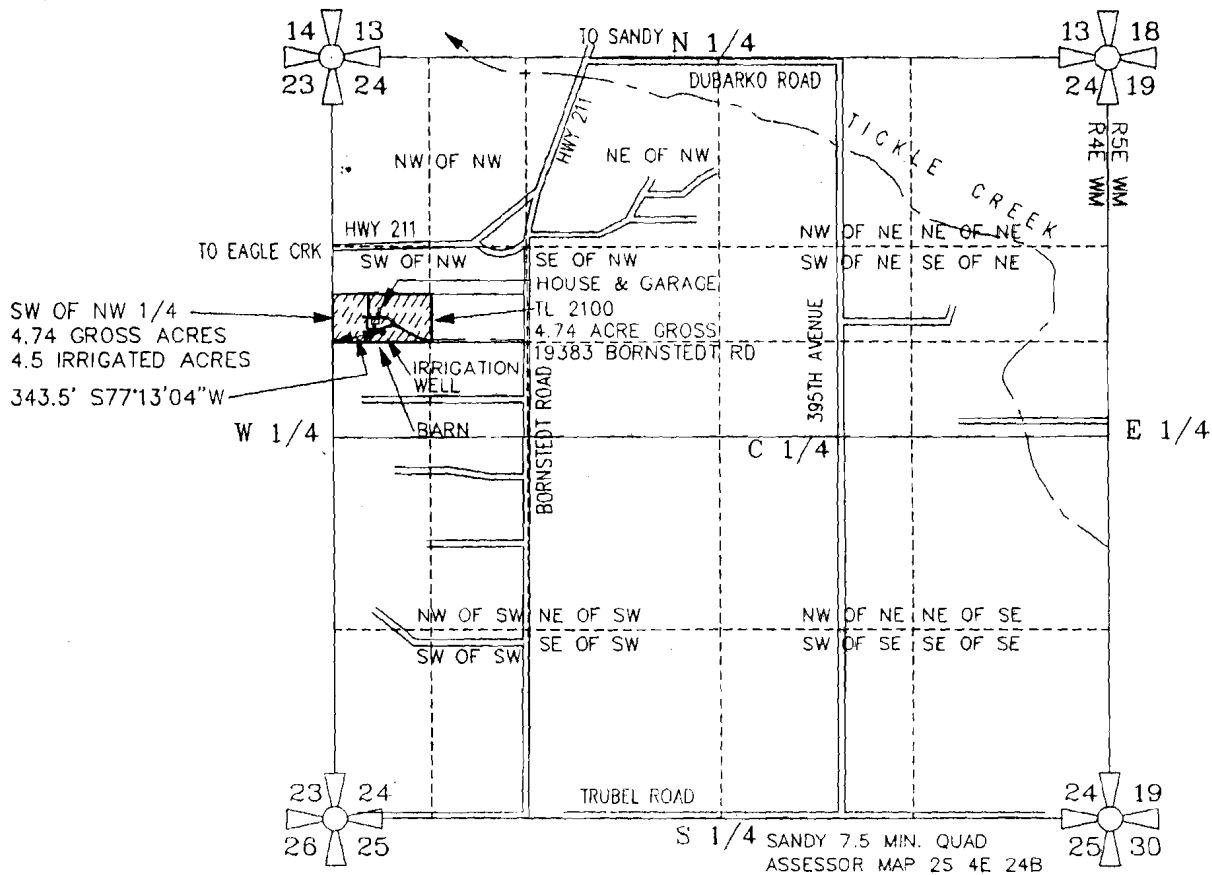


WELL IS LOCATED 76 FEET NORTH AND 335 FEET EAST OF
THE SOUTH-NORTH 1/64 CORNER OF SECTION 24, TOWNSHIP 2
SOUTH, RANGE 4 EAST OF WM, CLACKAMAS COUNTY, OREGON

PREPARATION OF THIS MAP WAS FOR THE PURPOSE
OF IDENTIFYING THE LOCATION OF THE WATER RIGHTS
ONLY AND HAS NO INTENT TO PROVIDE DIMENSIONS
OR LOCATION OF PROPERTY OWNERSHIP LINES.

FINAL PROOF SURVEY
GROUNDWATER PERMIT G-12765


PREPARED BY EDWARD A. CRANE, CWRE

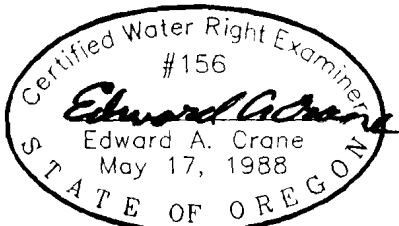

Renewal 12/31/97


Signed 3-24-97

SURVEYED JAN 20, 1997
BY EDWARD A. CRANE, CWRE

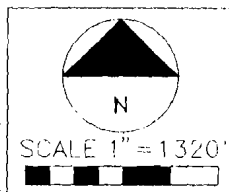

DATE
MAR 1997

PROJECT NO.
244-001

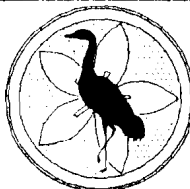


CRANE & MERSETH
Engineering/Surveying
SUITE "D"
6566 SE LAKE ROAD
MILWAUKIE, OREGON 97222
BUS: (503) 654-2005
FAX: (503) 654-2575

APPLICATION FOR PERMIT NUMBER G-14080
PERMIT NUMBER G-12765 IN THE NAME OF:

DAVID S. FLOOD
19383 SE BORNSTEDT ROAD
SANDY, OREGON 97255 (TEL: 503-668-9636)

SHEET
1/2

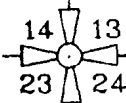



RECEIVED

MAR 25 1997

WATER RESOURCES DEPT
SALEM, OREGON

SW 1/4 OF THE NW 1/4
SECTION 24
T2S, R4E, WM
CLACKAMAS COUNTY, OREGON


WELL IS LOCATED 76 FEET NORTH AND 335 FEET EAST OF
THE SOUTH-NORTH 1/64 CORNER OF SECTION 24, TOWNSHIP 2
SOUTH, RANGE 4 EAST OF WM, CLACKAMAS COUNTY, OREGON

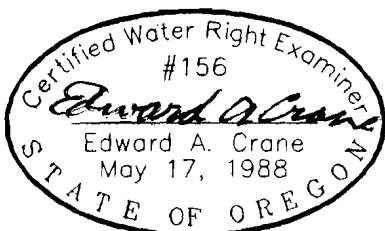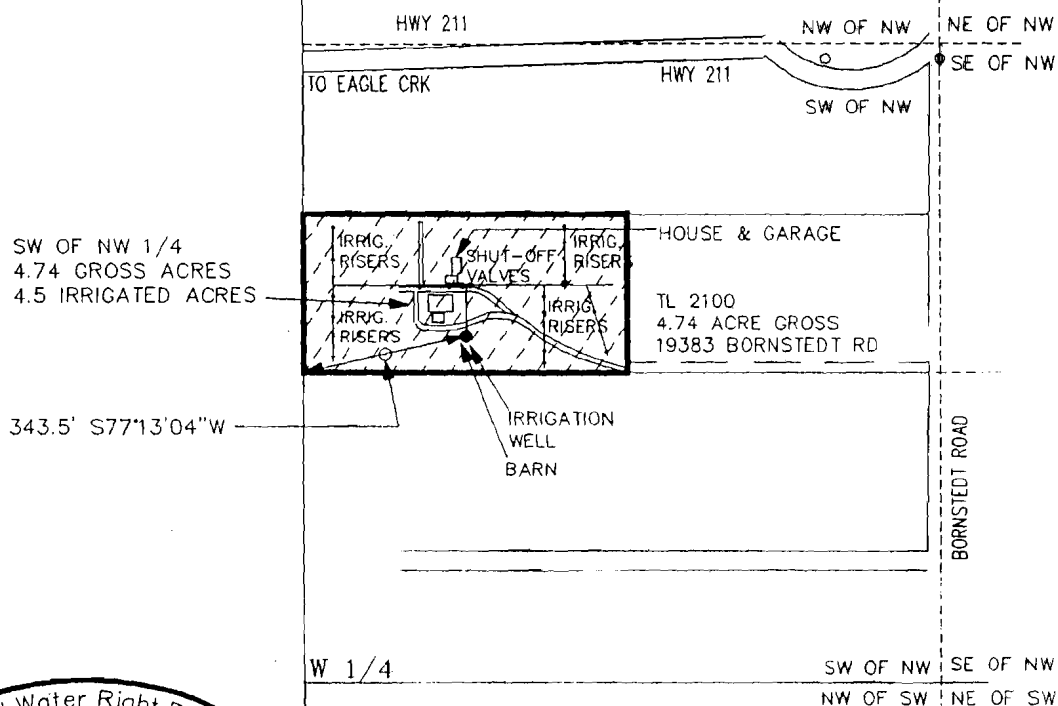

Renewal 12/31/97
Signed *Edward A. Crane*

SURVEYED JAN 20, 1997
BY EDWARD A. CRANE, CWRE

K:\CAD\244-001\24400101.DWG 1/24/97 EAC

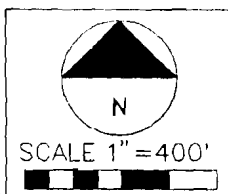

PREPARATION OF THIS MAP WAS FOR THE PURPOSE
OF IDENTIFYING THE LOCATION OF THE WATER RIGHTS
ONLY AND HAS NO INTENT TO PROVIDE DIMENSIONS
OR LOCATION OF PROPERTY OWNERSHIP LINES.

FINAL PROOF SURVEY
GROUNDWATER PERMIT G-12765

PREPARED BY EDWARD A. CRANE, CWRE

DATE
MAR 1997

PROJECT NO.
244-001



CRANE & MERSETH
Engineering/Surveying
SUITE "D"
6566 SE LAKE ROAD
MILWAUKIE, OREGON 97222
BUS: (503) 654-2005
FAX: (503) 654-2575

APPLICATION FOR PERMIT NUMBER G-14080
PERMIT NUMBER G-12765 IN THE NAME OF

DAVID S. FLOOD
19383 SE BORNSTEDT ROAD
SANDY, OREGON 97255 (TEL: 503-668-9636)

SHEET

2/2