


**RAINBOW ROCK SERVICE ASSOC.
WATER DELIVERY SYSTEM**
SCALE: 1 IN = 400 FT.

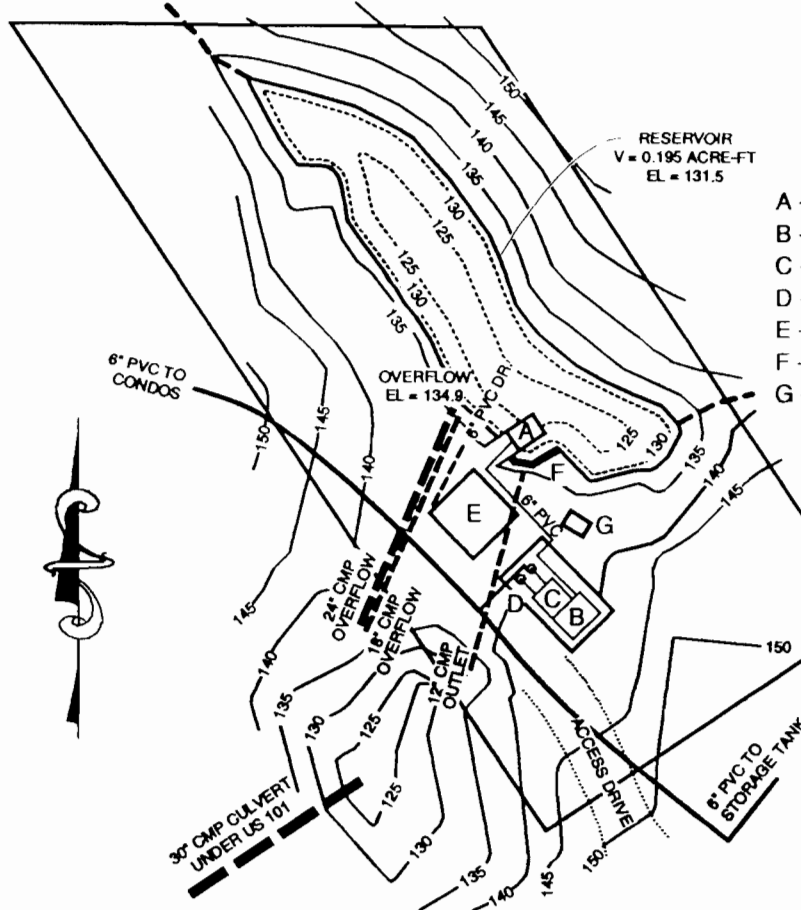

DETAIL OF TAX LOT 102
SCALE: 1 IN = 50 FT.

DETAIL LEGEND

- A - 2 - 1½ HP pumps
- B - Filtration System
- C - Steel tank
- D - 2 - 5 HP pumps (alternating)
- E - Backflush settling basin
- F - Pond spillway, elev. = 131.5
- G - Power transformer

NOTE:
The preparation of this map was for the purpose of identifying the location of the proposed water right and has no intent to provide dimensions or location of property lines.

**Section 26, T 40 S, R 14 W, W.M.,
Curry County, Oregon**
FINAL PROOF SURVEY

Application # 72637 Permit # 52635
Application # R-80754 Permit # R-11933
in the name of Rainbow Rock Service Assoc.
Surveyed July 10, 1997 by H. J. Newhouse

H. J. Newhouse - Land Surveying
P.O. Box 360
Wedderburn, Oregon 97491
(503) 247-6923
C.W.R.E. # 095



Rainbow Rock Service Assn., Inc.
17744 Hwy. 101 North, #100
Brookings, Oregon 97415

RECEIVED
JUN 22 1998