


**RAINBOW ROCK SERVICE ASSOC.  
WATER DELIVERY SYSTEM**

SCALE: 1 IN = 400 FT.

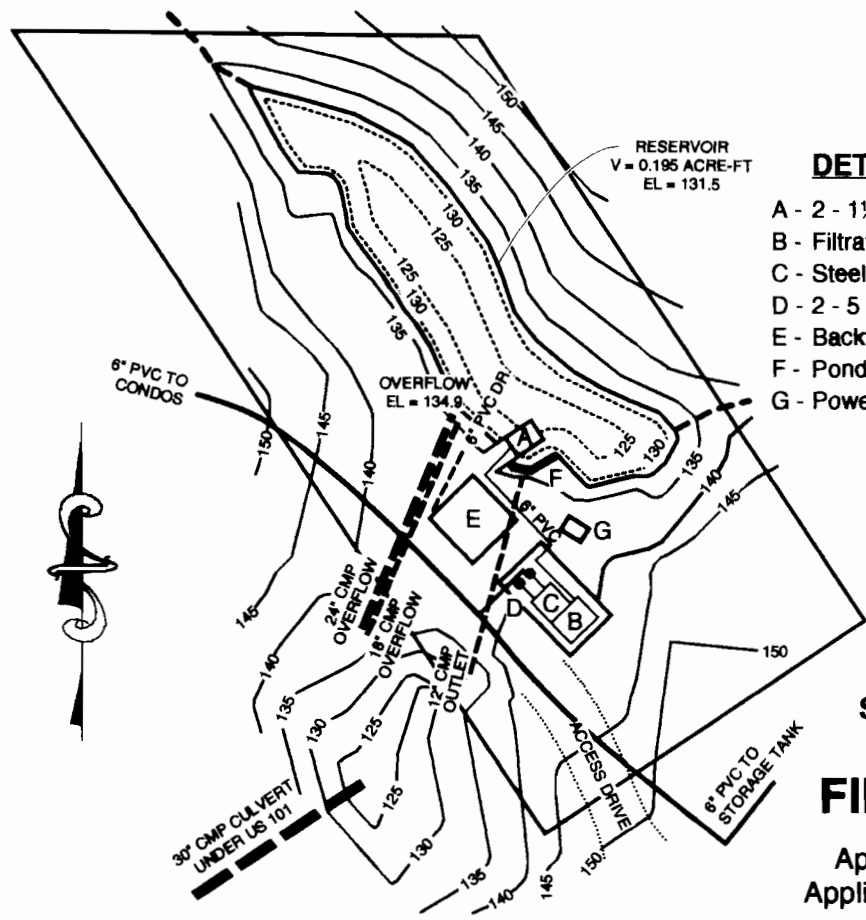

**DETAIL OF TAX LOT 102**

SCALE: 1 IN = 50 FT.

**DETAIL LEGEND**

- A - 2 - 1 1/2 HP pumps
- B - Filtration System
- C - Steel tank
- D - 2 - 5 HP pumps (alternating)
- E - Backflush settling basin
- F - Pond spillway, elev. = 131.5
- G - Power transformer

**NOTE:**

The preparation of this map was for the purpose of identifying the location of the proposed water right and has no intent to provide dimensions or location of property lines.

Section 26, T 40 S, R 14 W, W.M.,  
Curry County, Oregon


**FINAL PROOF SURVEY**

Application # 72637      Permit # 52635  
Application # R-80754      Permit # R-11933

in the name of Rainbow Rock Service Assoc.

Surveyed July 10, 1997 by H. J. Newhouse

H. J. Newhouse - Land Surveying  
P.O. Box 360  
Wedderburn, Oregon 97491  
(503) 247-6923  
C.W.R.E. # 095

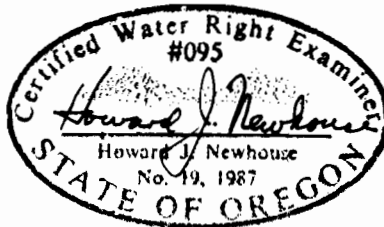

Rainbow Rock Service Assn., Inc.  
17744 Hwy. 101 North, #100  
Brookings, Oregon 97415